


T.35S., R.4W., W.M.

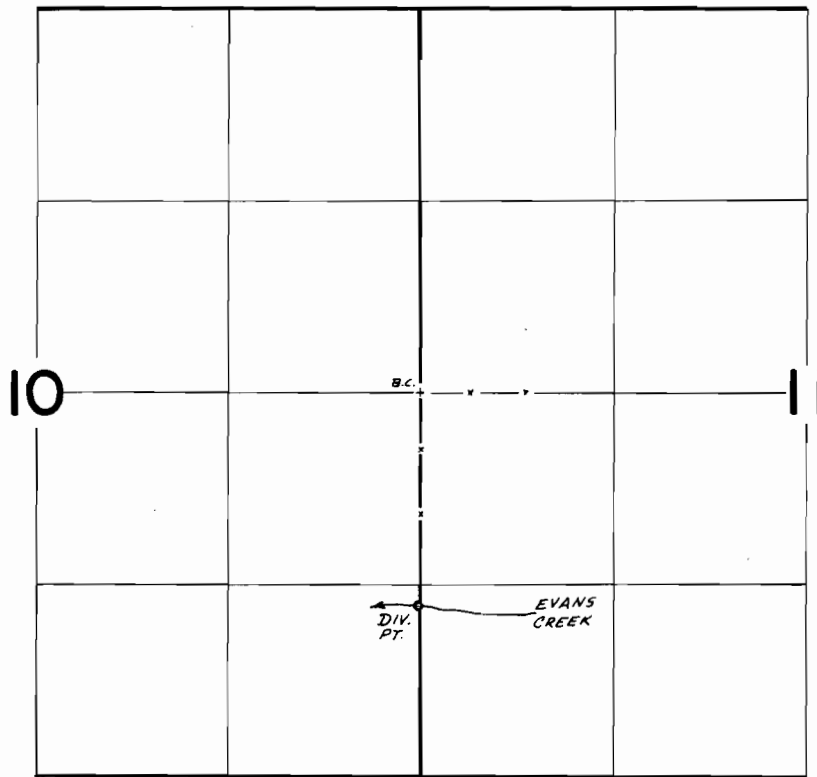

DIV. PT. LOC: 1400' S & 10' W FROM E $\frac{1}{4}$ COR SEC. 10

FINAL PROOF SURVEY
UNDER

Transfer No. 2902
Application No. Permit No.
IN NAME OF

KENNETH S. JOCHEM

Surveyed May 6 1975, by D. Norby