



# Township 5 South, Range 1 West, W. M.

Portions of Sections 26, 27, 34 & 35

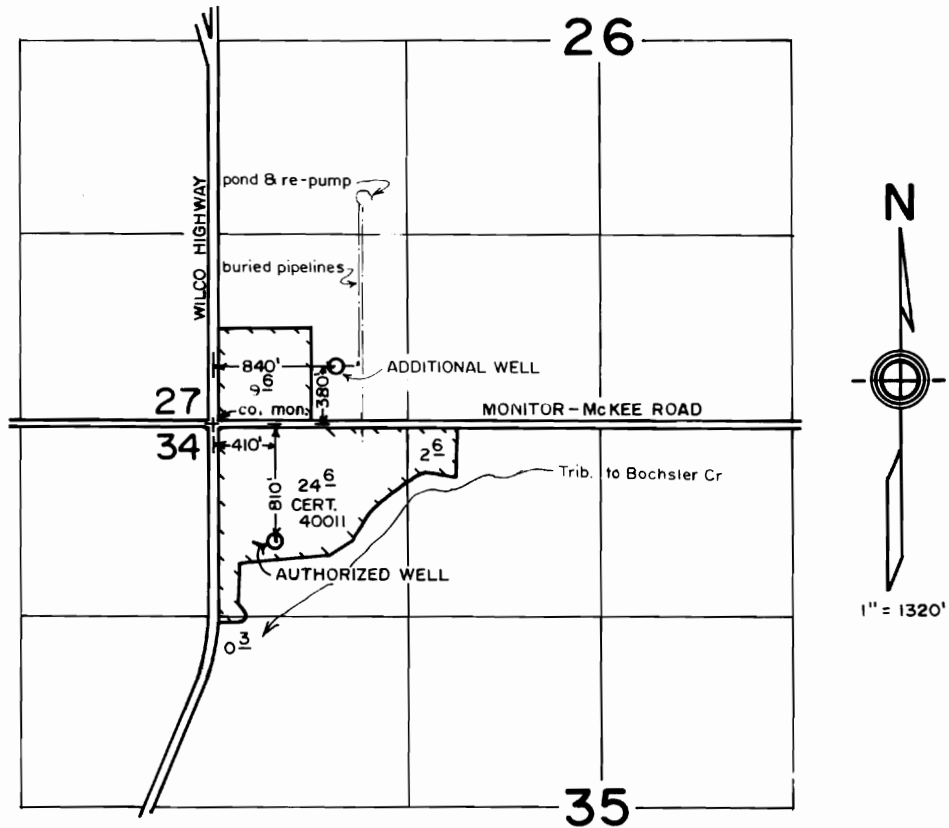

FINAL PROOF SURVEY  
under  
Transfer 6600  
in name of  
CHARLES E. BOCHSLER  
Jan. 15, 1996

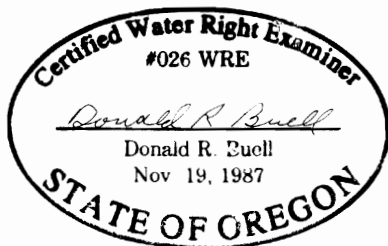

THIS MAP WAS PREPARED FOR THE PURPOSE OF IDENTIFYING THE LOCATION OF A WATER RIGHT ONLY AND IS NOT INTENDED TO PROVIDE LEGAL DIMENSIONS OR LOCATION OF PROPERTY OWNERSHIP LINES.