


T. 38 S., R. 1 W., W.M.

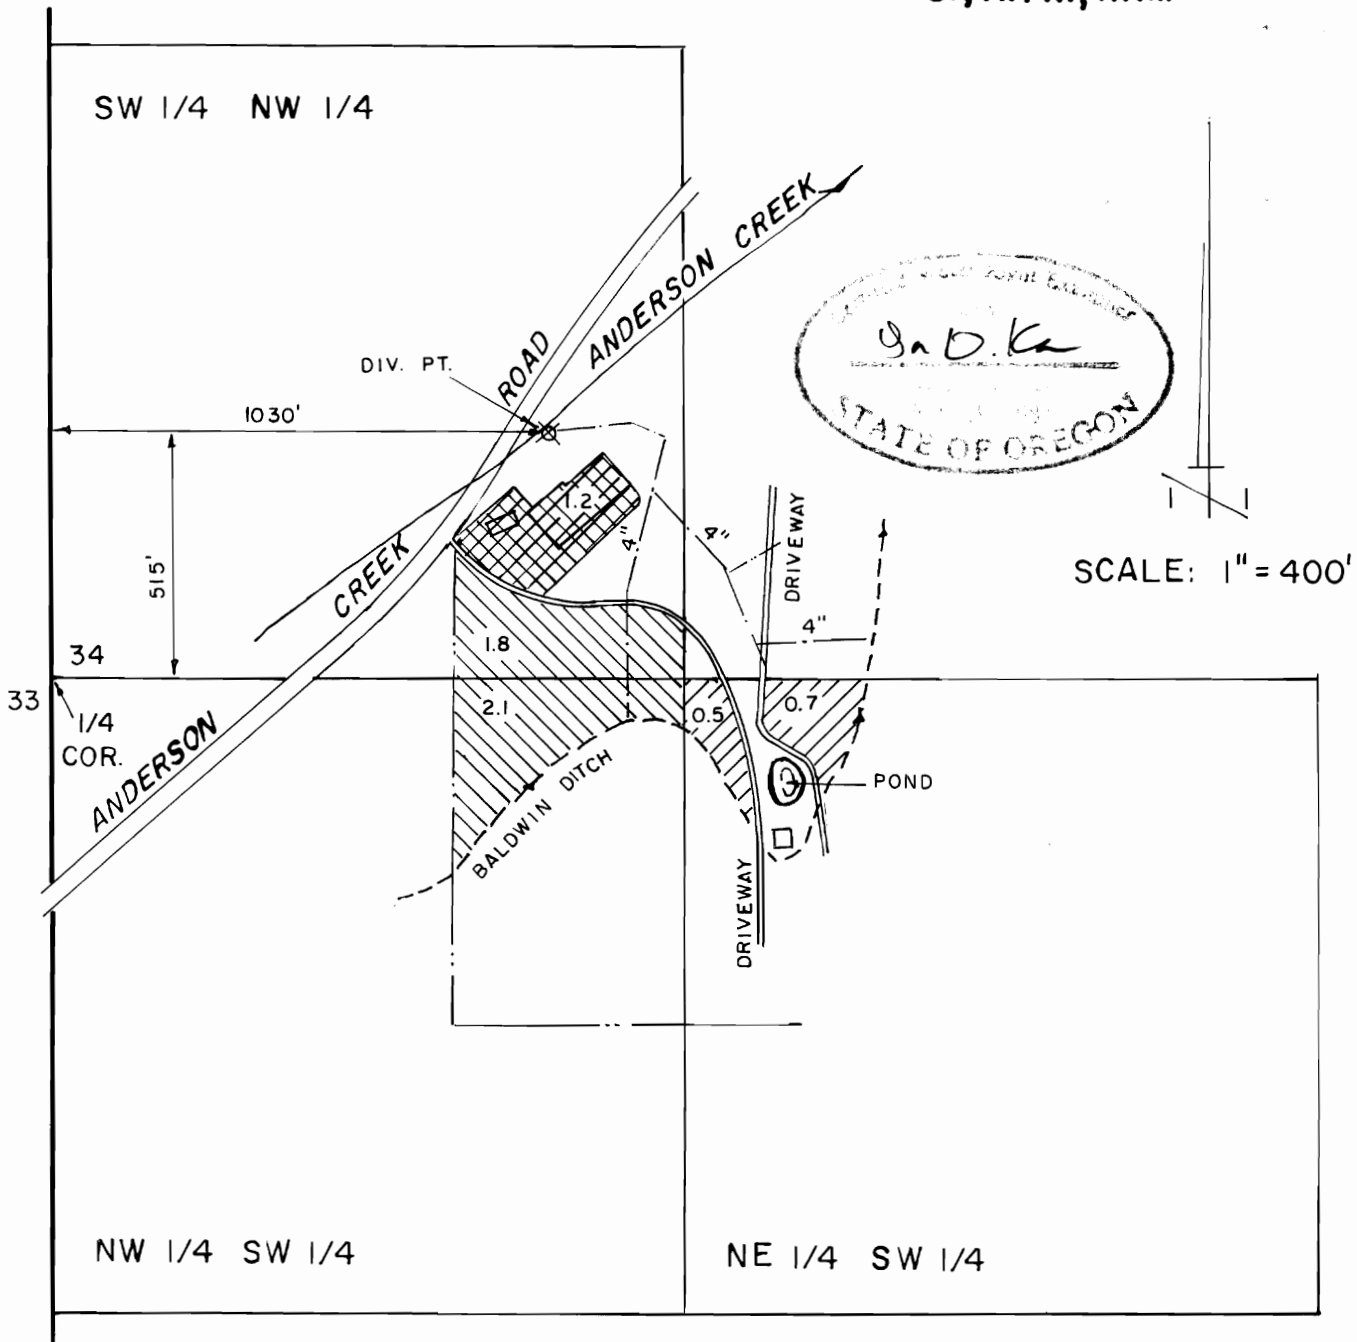

FINAL PROOF MAP

APPLICATION No. T-6612

IN THE NAME OF

WARREN J. FERGUSON

MAP PREPARED AUGUST 17, 1994 BY GARY D. KAISER

NOTE: THIS MAP HAS BEEN
PREPARED FOR WATER RIGHT
PURPOSES ONLY, NOT FOR
PROPERTY BOUNDARY LOCATIONS



CHANGE IN DIVERSION
ONLY



CHANGE IN DIVERSION
AND NEW PLACE OF
USE



AREA BEING TRANSFERED
FROM