


Final Proof Survey for  
Water Right Transfer T-6622  
Section 2, T.29S, R.12W, W.M.

RECEIVED

AUG 13 1996

WATER RESOURCES DEPT  
SALEM, OREGON

in Name of  
Charles and Mabel Leibelt  
Surveyed August 2, 1996

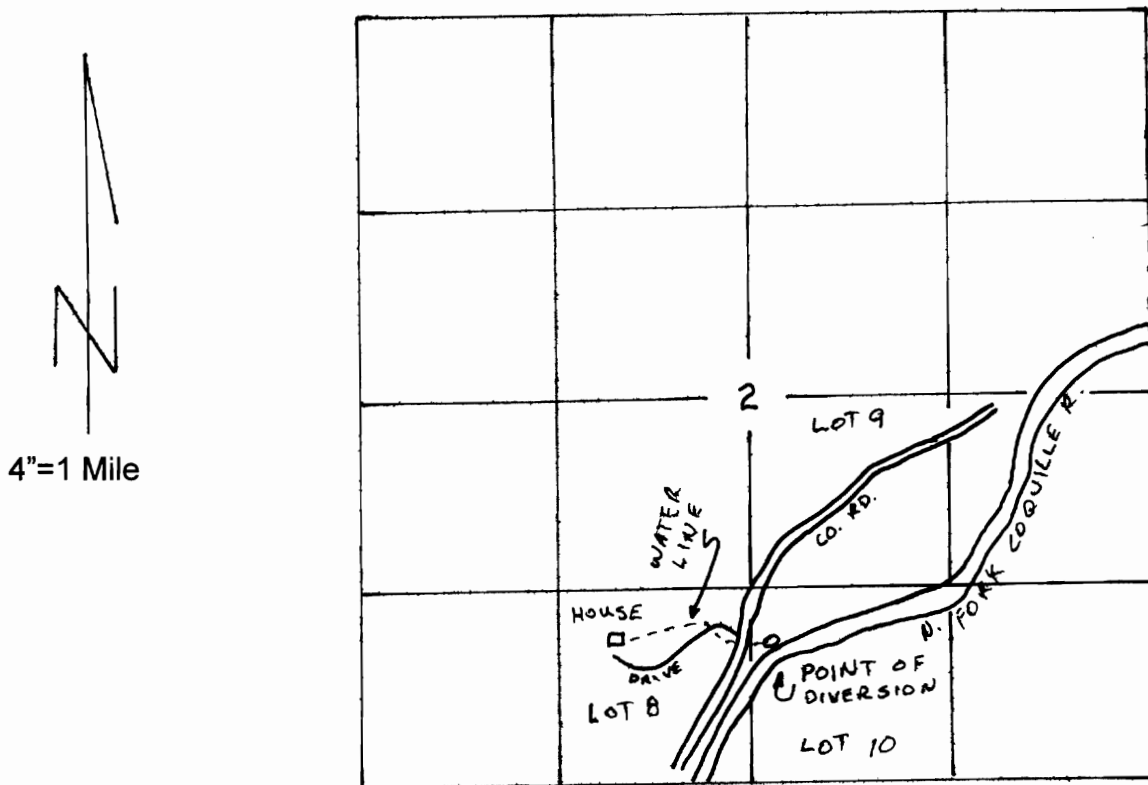

Point of diversion located 819.9' N and 1,447.5' E  
from S.W. corner Lot 8.

The purpose of this map is to identify the location of the  
water right transfer, not the location of ownership lines.

Surveyed by  
John Minor  
C.W.R.E. #91

