


T. 1 S. R. 9 W. W. M.

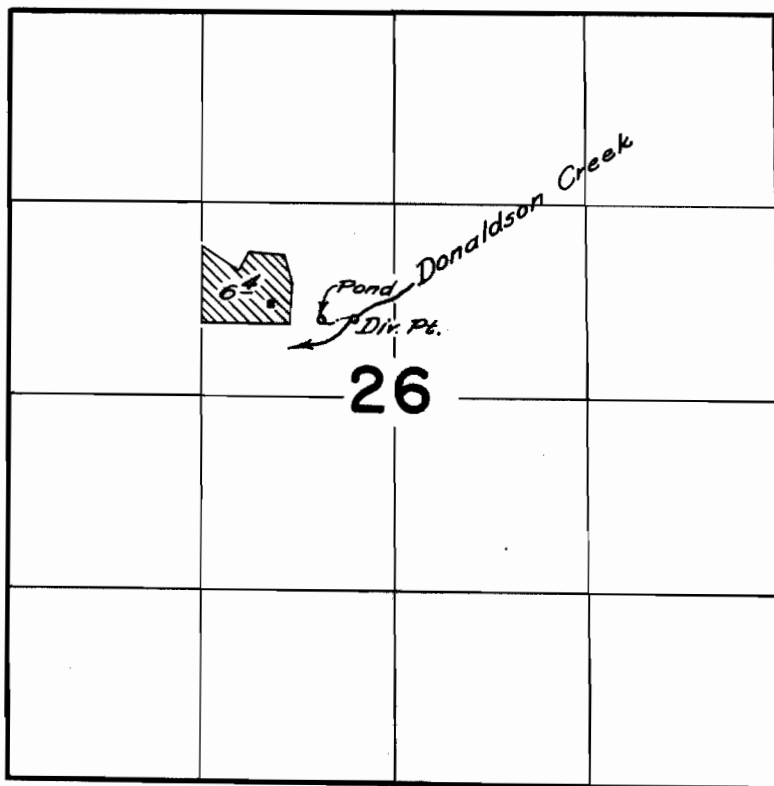

**FINAL PROOF SURVEY**  
UNDER

Application No. 29143 Permit No. 22982  
IN NAME OF

Martin V. & Vivian G. Clark

Surveyed June 27, 1961, by C. Bastin