


T. 5 S., R. 3 W., W.M.

Yamhill County, Oregon

RECEIVED

NOV 25 1991

WATER RESOURCES DEP
SALEM, OREGON

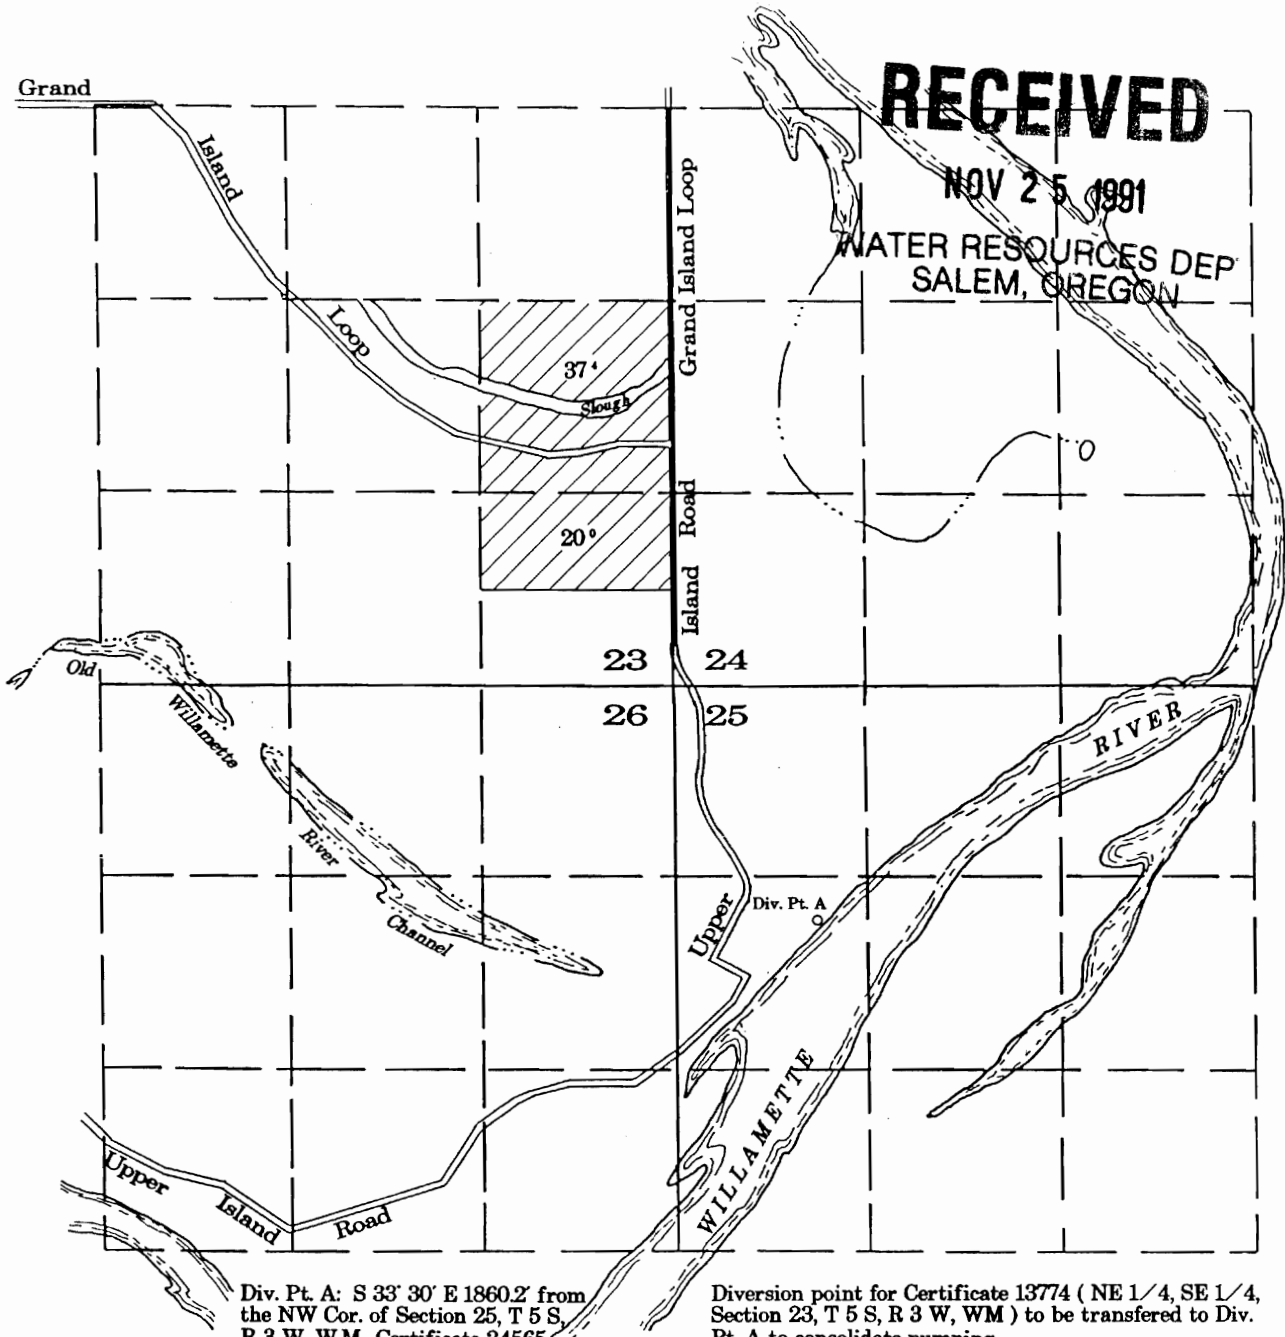

Div. Pt. A: S 33° 30' E 1860.2' from
the NW Cor. of Section 25, T 5 S,
R 3 W, W.M., Certificate 24565

Diversion point for Certificate 13774 (NE 1/4, SE 1/4,
Section 23, T 5 S, R 3 W, WM) to be transferred to Div.
Pt. A to consolidate pumping.

17950


13631

Application No. File 45 Permit No. _____

A & R SPADA FARMS

October 22, 1991
Scale: 1" = 1320'

NOTE: This map is for the purpose of
identifying the location of water rights
and has no intent to dimension or locate
property ownership lines.

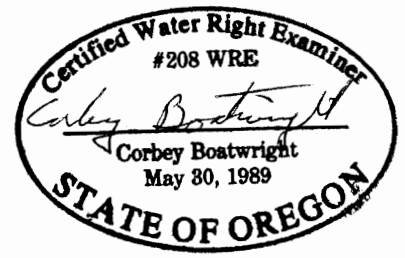

APPLICATION TO TRANSFER POINT OF DIVERSION