
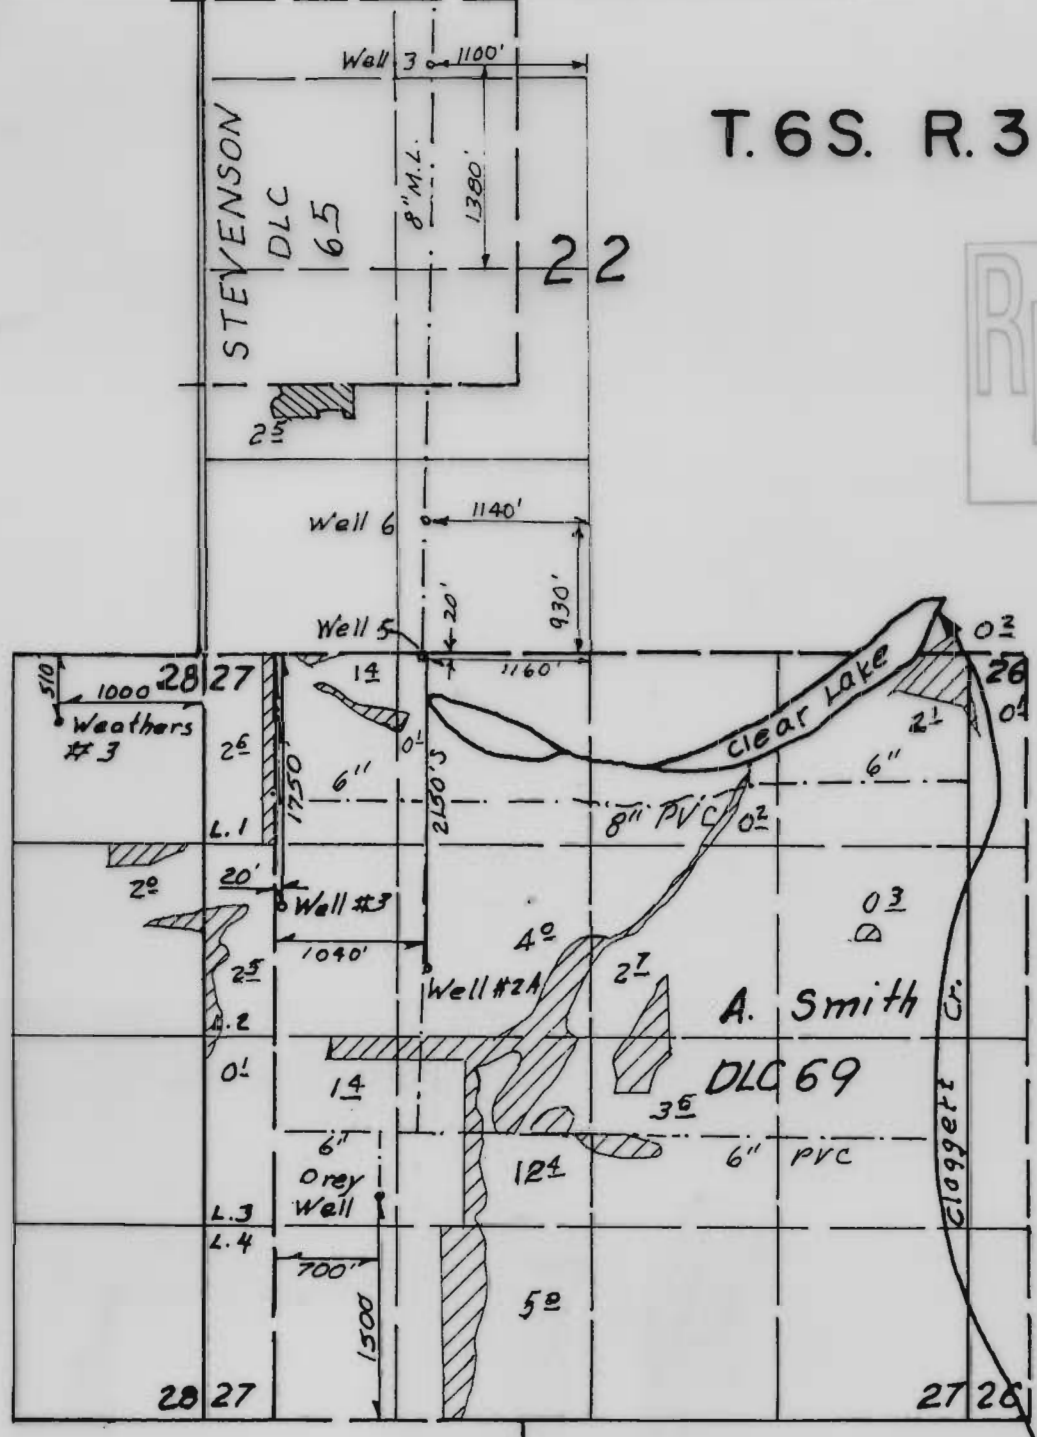



T. 6 S. R. 3 W. W.M.

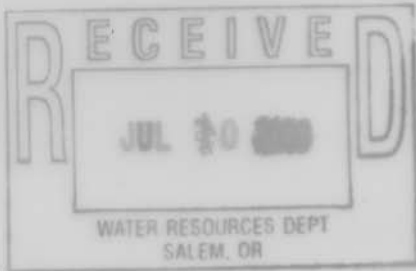

FINAL PROOF SURVEY
UNDER

Transfer No. T-7018
Application No. Permit No.
IN NAME OF
.....MILLER FOREST, INC.....

Surveyed March 22, 2000 by

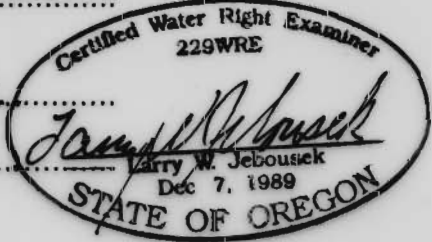

THIS MAP WAS PREPARED FOR THE PURPOSE OF IDENTIFYING THE LOCATION OF A WATER RIGHT ONLY AND IS NOT INTENDED TO PROVIDE LEGAL DIMENSIONS OR LOCATION OF PROPERTY OWNERSHIP LINES.