
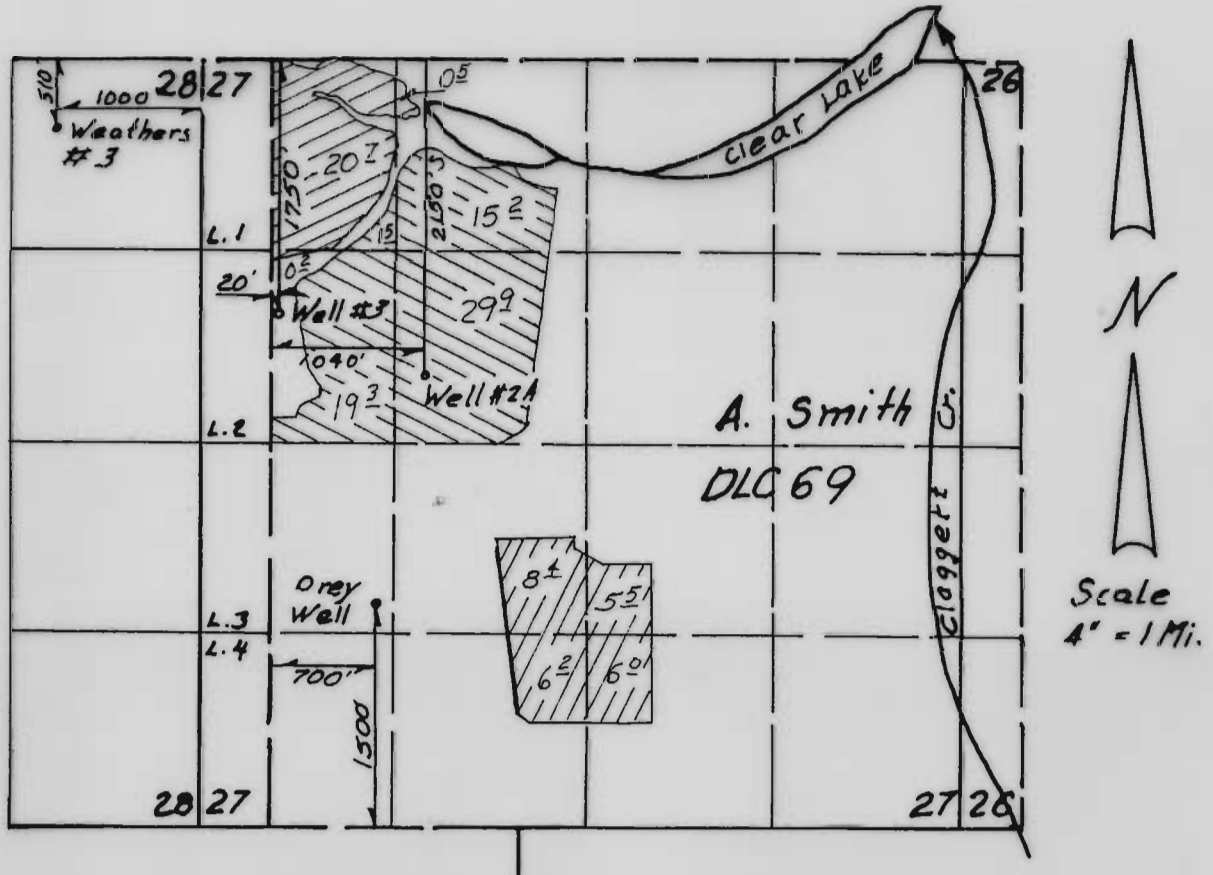


T.6S. R.3W. W.M.

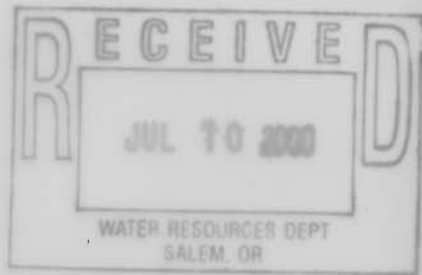


Cert. 35019 [hatched pattern] Wells 1 & 2 well 3
Cert. 57923 [diagonal hatched pattern]

FINAL PROOF SURVEY
UNDER

Transfer No. T-7020
~~Application No. G-14297 Permit No. G-13194...~~
IN NAME OF

.....MILLER FOREST, INC.

Surveyed Mar. 22., 2000, by

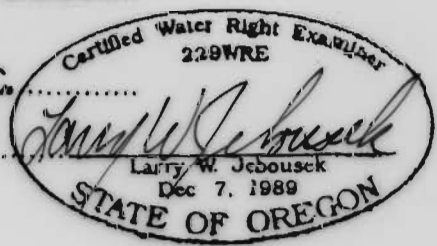

THIS MAP WAS PREPARED FOR THE PURPOSE OF IDENTIFYING THE LOCATION OF A WATER RIGHT ONLY AND IS NOT INTENDED TO PROVIDE LEGAL DIMENSIONS OR LOCATION OF PROPERTY OWNERSHIP LINES.