


RECEIVED

AUG 27 1999

WATER RESOURCES DEPT.  
SALEM, OREGON

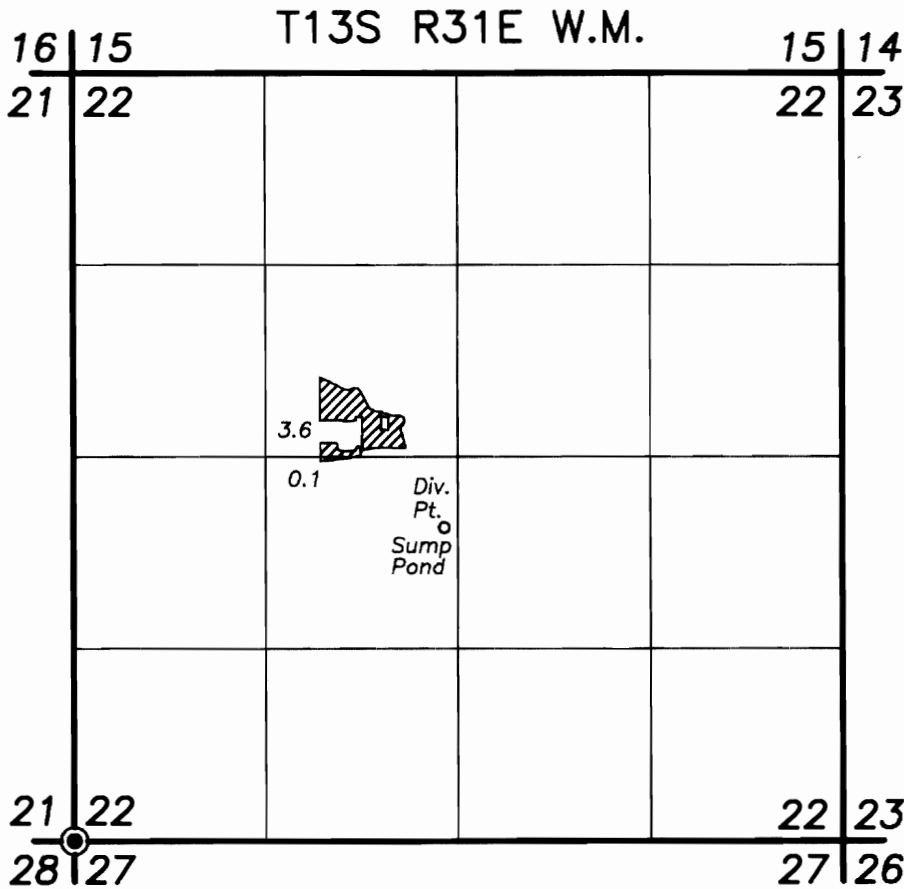

SCALE 1" = 1320'

Div. Pt. is 2150' N. and 2550' E. of the SW cor. Sec. 22.

**FINAL PROOF SURVEY  
UNDER**

TRANSFER NO. 6671  
SPECIAL ORDER VOL. 51, PG. 324-325

IN NAME OF  
**WILLIAM A. & BLANCHE PATTERSON**

SURVEYED AUGUST 6, 1999  
BY ROBERT D. BAGETT

 PLACE  
OF USE

NOTE: The preparation of this map was for the purpose of identifying the location of the proposed water right and has no intent to provide dimensions or location of property ownership lines. Location information shown hereon was furnished by the applicant.

