


T.6S.,R.2W.,W.M.

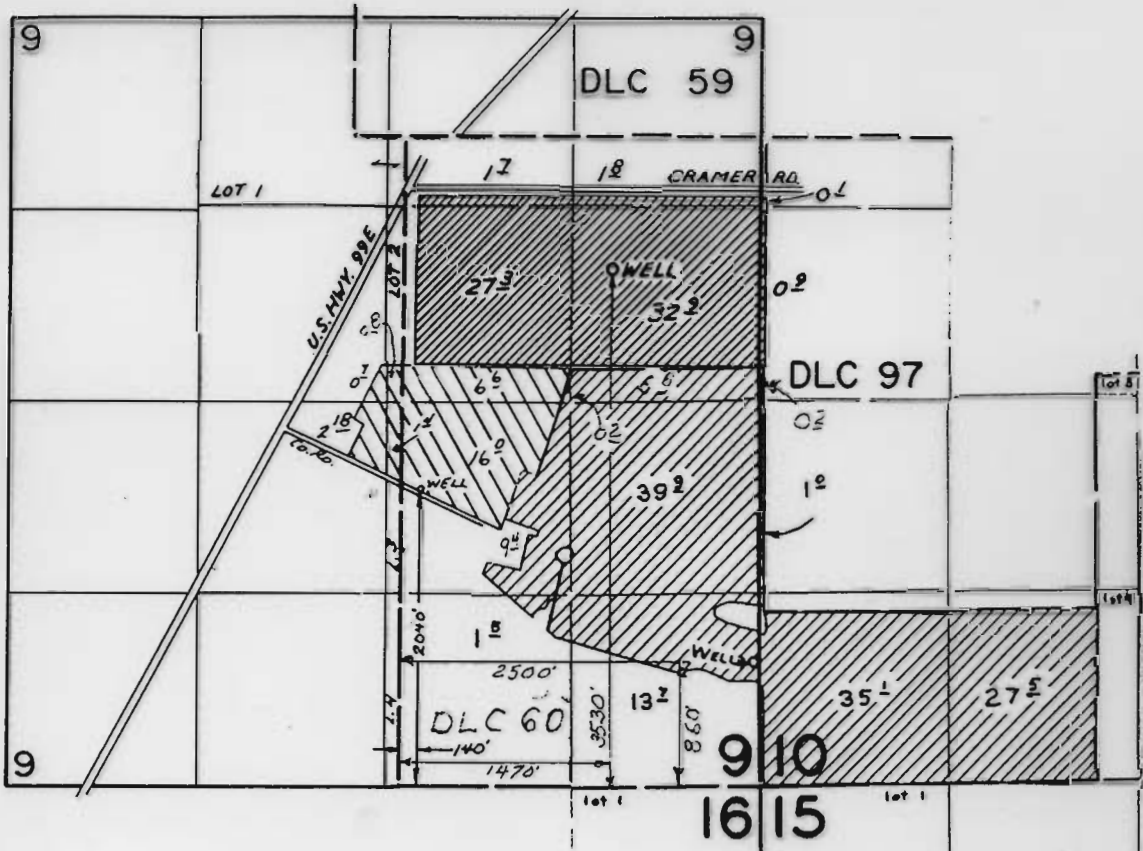

WATER RIGHT MAP FOR

BOB FESSLER

RECEIVED
AUG 17 1989
WATER RESOURCES DIV

THIS MAP WAS PREPARED FOR THE PURPOSE OF IDENTIFYING THE LOCATION OF A WATER RIGHT ONLY AND IS NOT INTENDED TO PROVIDE LEGAL DIMENSIONS OR LOCATION OF PROPERTY OWNERSHIP LINES.

T 7030

