



T. 16 S., R. 3 W., W.M.

SECTION 17.

FINAL PROOF MAP T 7033

MUDDY CREEK IRRIGATION PROJECT


LANE COUNTY, OREGON

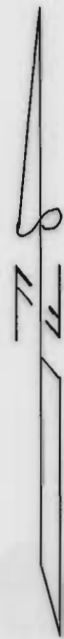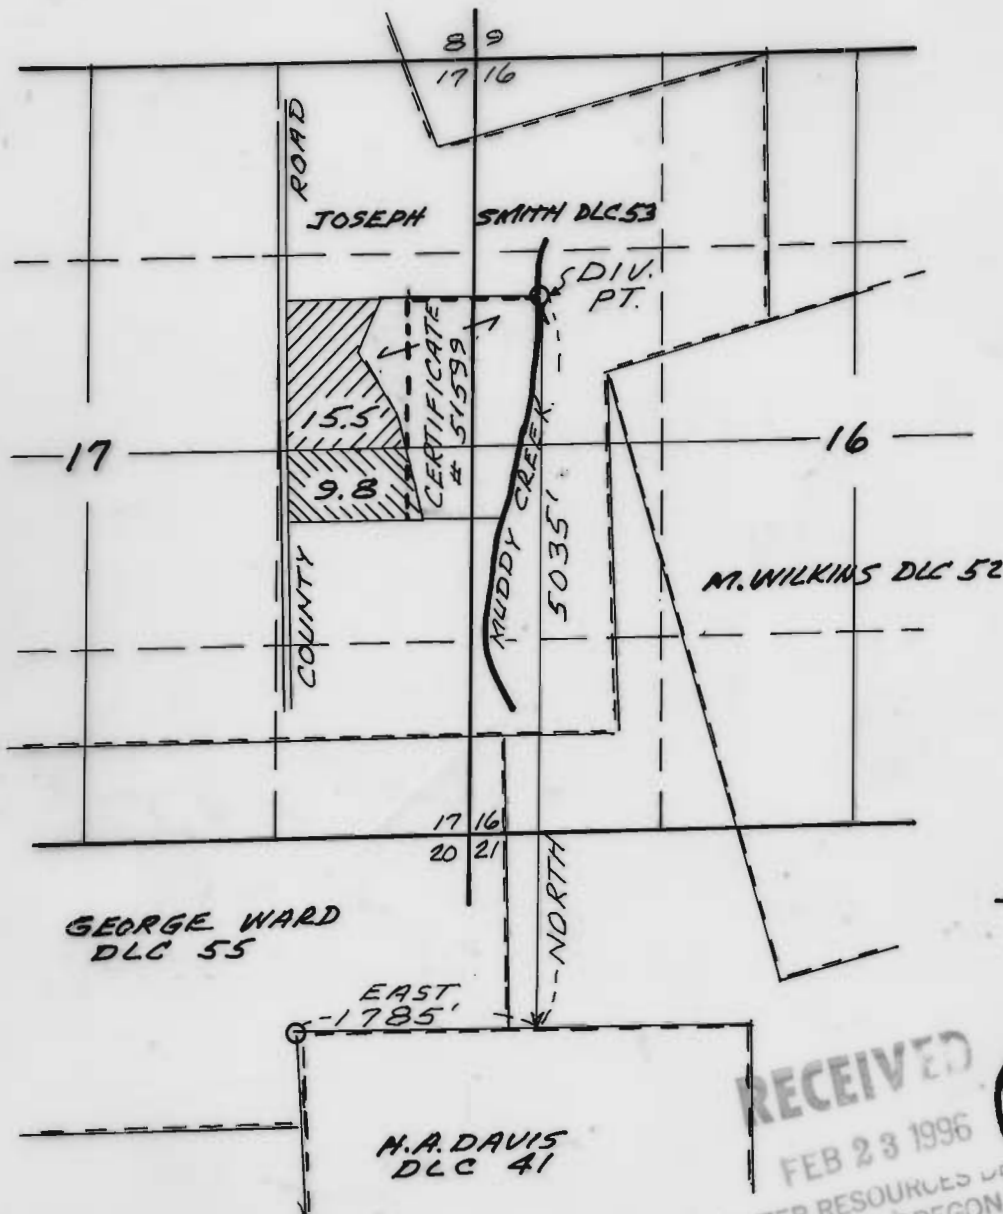

SCALE
1" = 1320'

--- = MAIN LINE
MARCH 21, 1994
EXP. DATE 6/30/1995

RECEIVED
FEB 23 1996

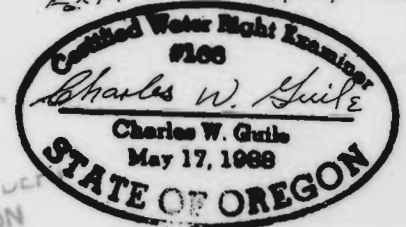


TRANSFER T 7033
SURVEYED FEBRUARY 3, 1994
BY CHARLES W. GUILÉ

THIS MAP IS FOR WATER RIGHT
PURPOSES ONLY AND IS NOT
INTENDED TO PROVIDE DIMENSIONS
FOR LOCATING PROPERTY BOUNDARIES.