


RECEIVED

JUN - 2 1998

WATER RESOURCES DEP  
SALEM, OREGON

# Township 4 South, Range 1 East, W.M.

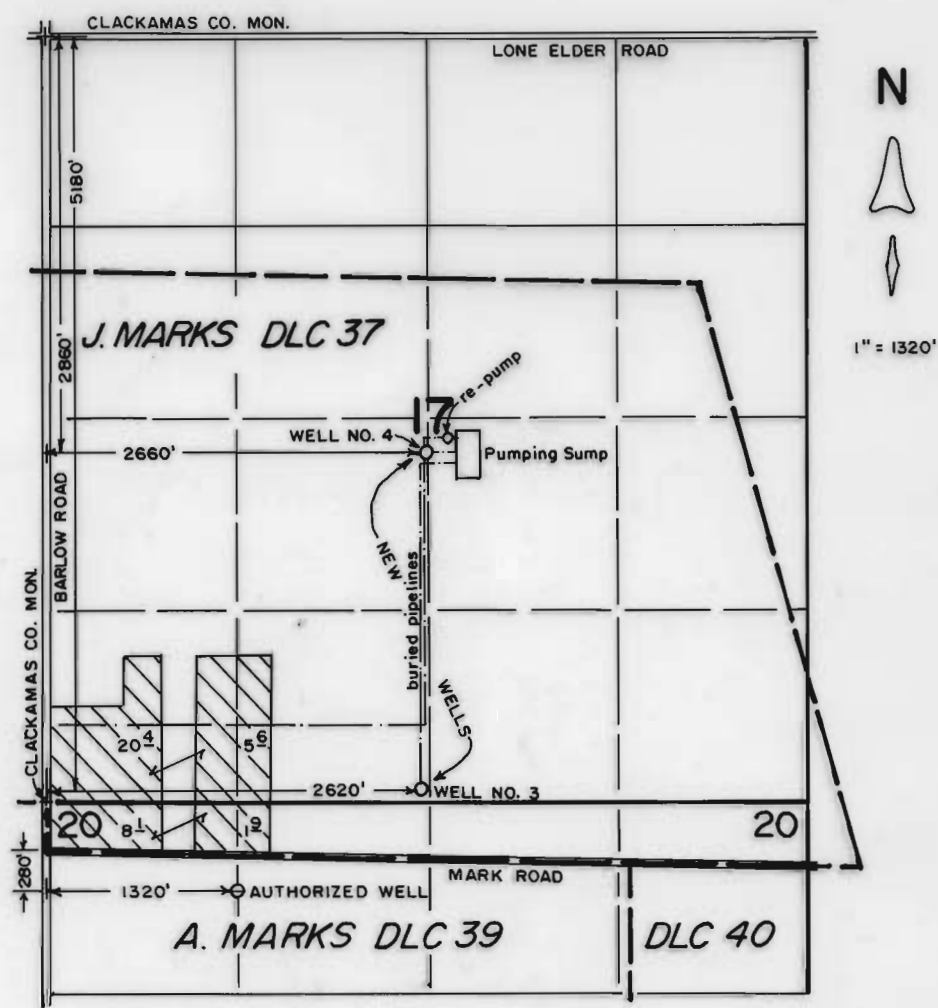

FINAL PROOF SURVEY  
under

Transfer No. 7042  
in name of

J. FRANK SCHMIDT & SON CO.  
Mar. 11, 1998

