


T.3N.R.29E.W.M.

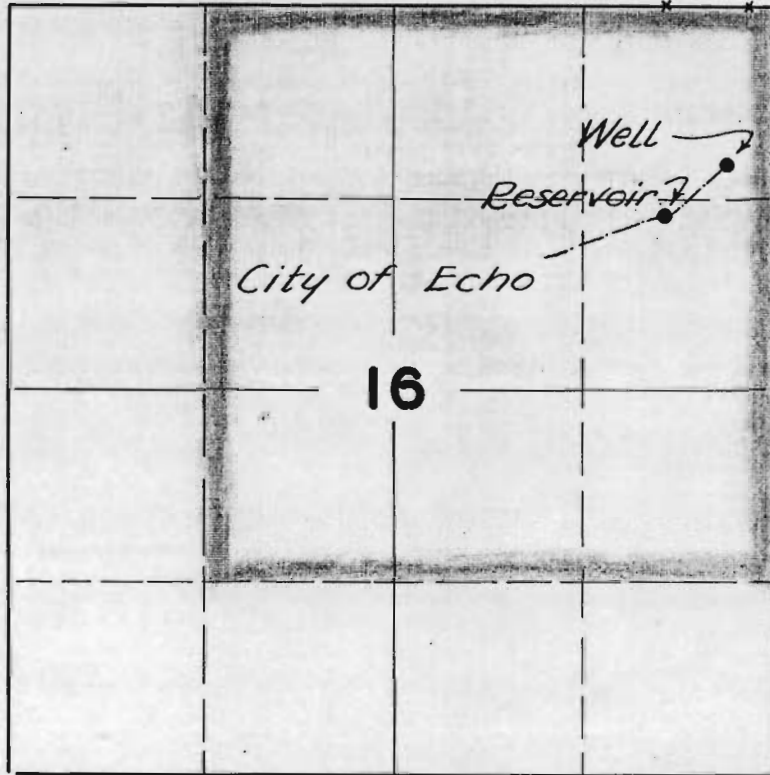

FINAL PROOF SURVEY

UNDER

Application No. U_175_ Permit No. U_168_

IN NAME OF

.....CITY OF ECHO.....

Surveyed OCT. 5. 1950., by H.L. COFFMAN.