


T.4N.R.27E.W.M.

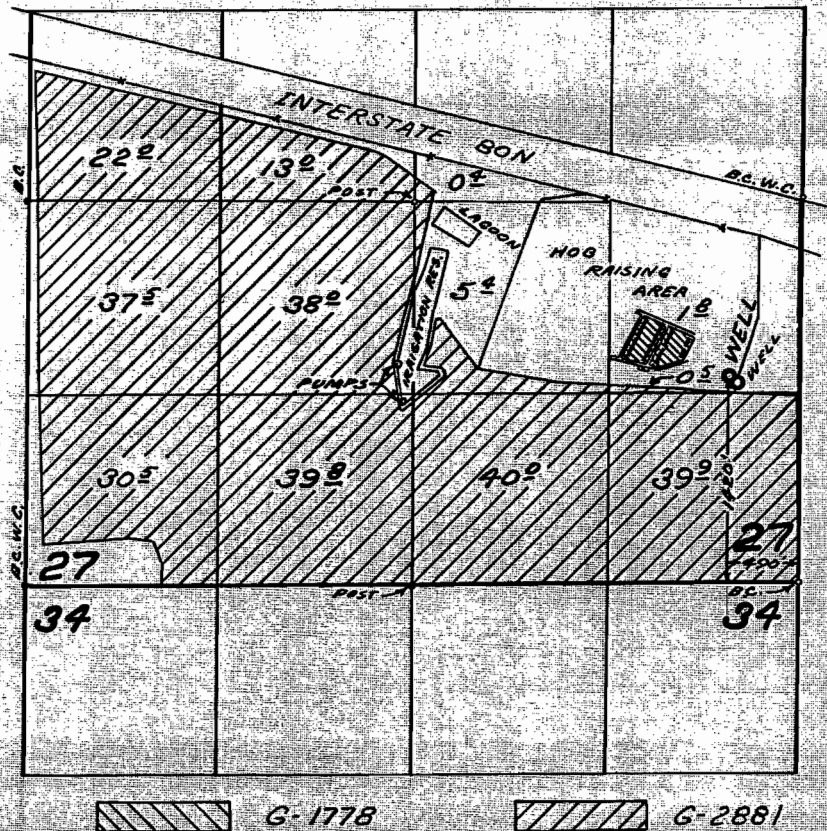

FINAL PROOF SURVEY
UNDER

Application No. G-1778 Permit No. G-1671
G-2881 G-2672
IN NAME OF

HANSELL BROTHERS, INC.


Surveyed JUN 20 1967, by L. GOULD

COPY


RECEIVED

DEC 18 1996

WATER RESOURCES DEPT.
SALEM, OREGON

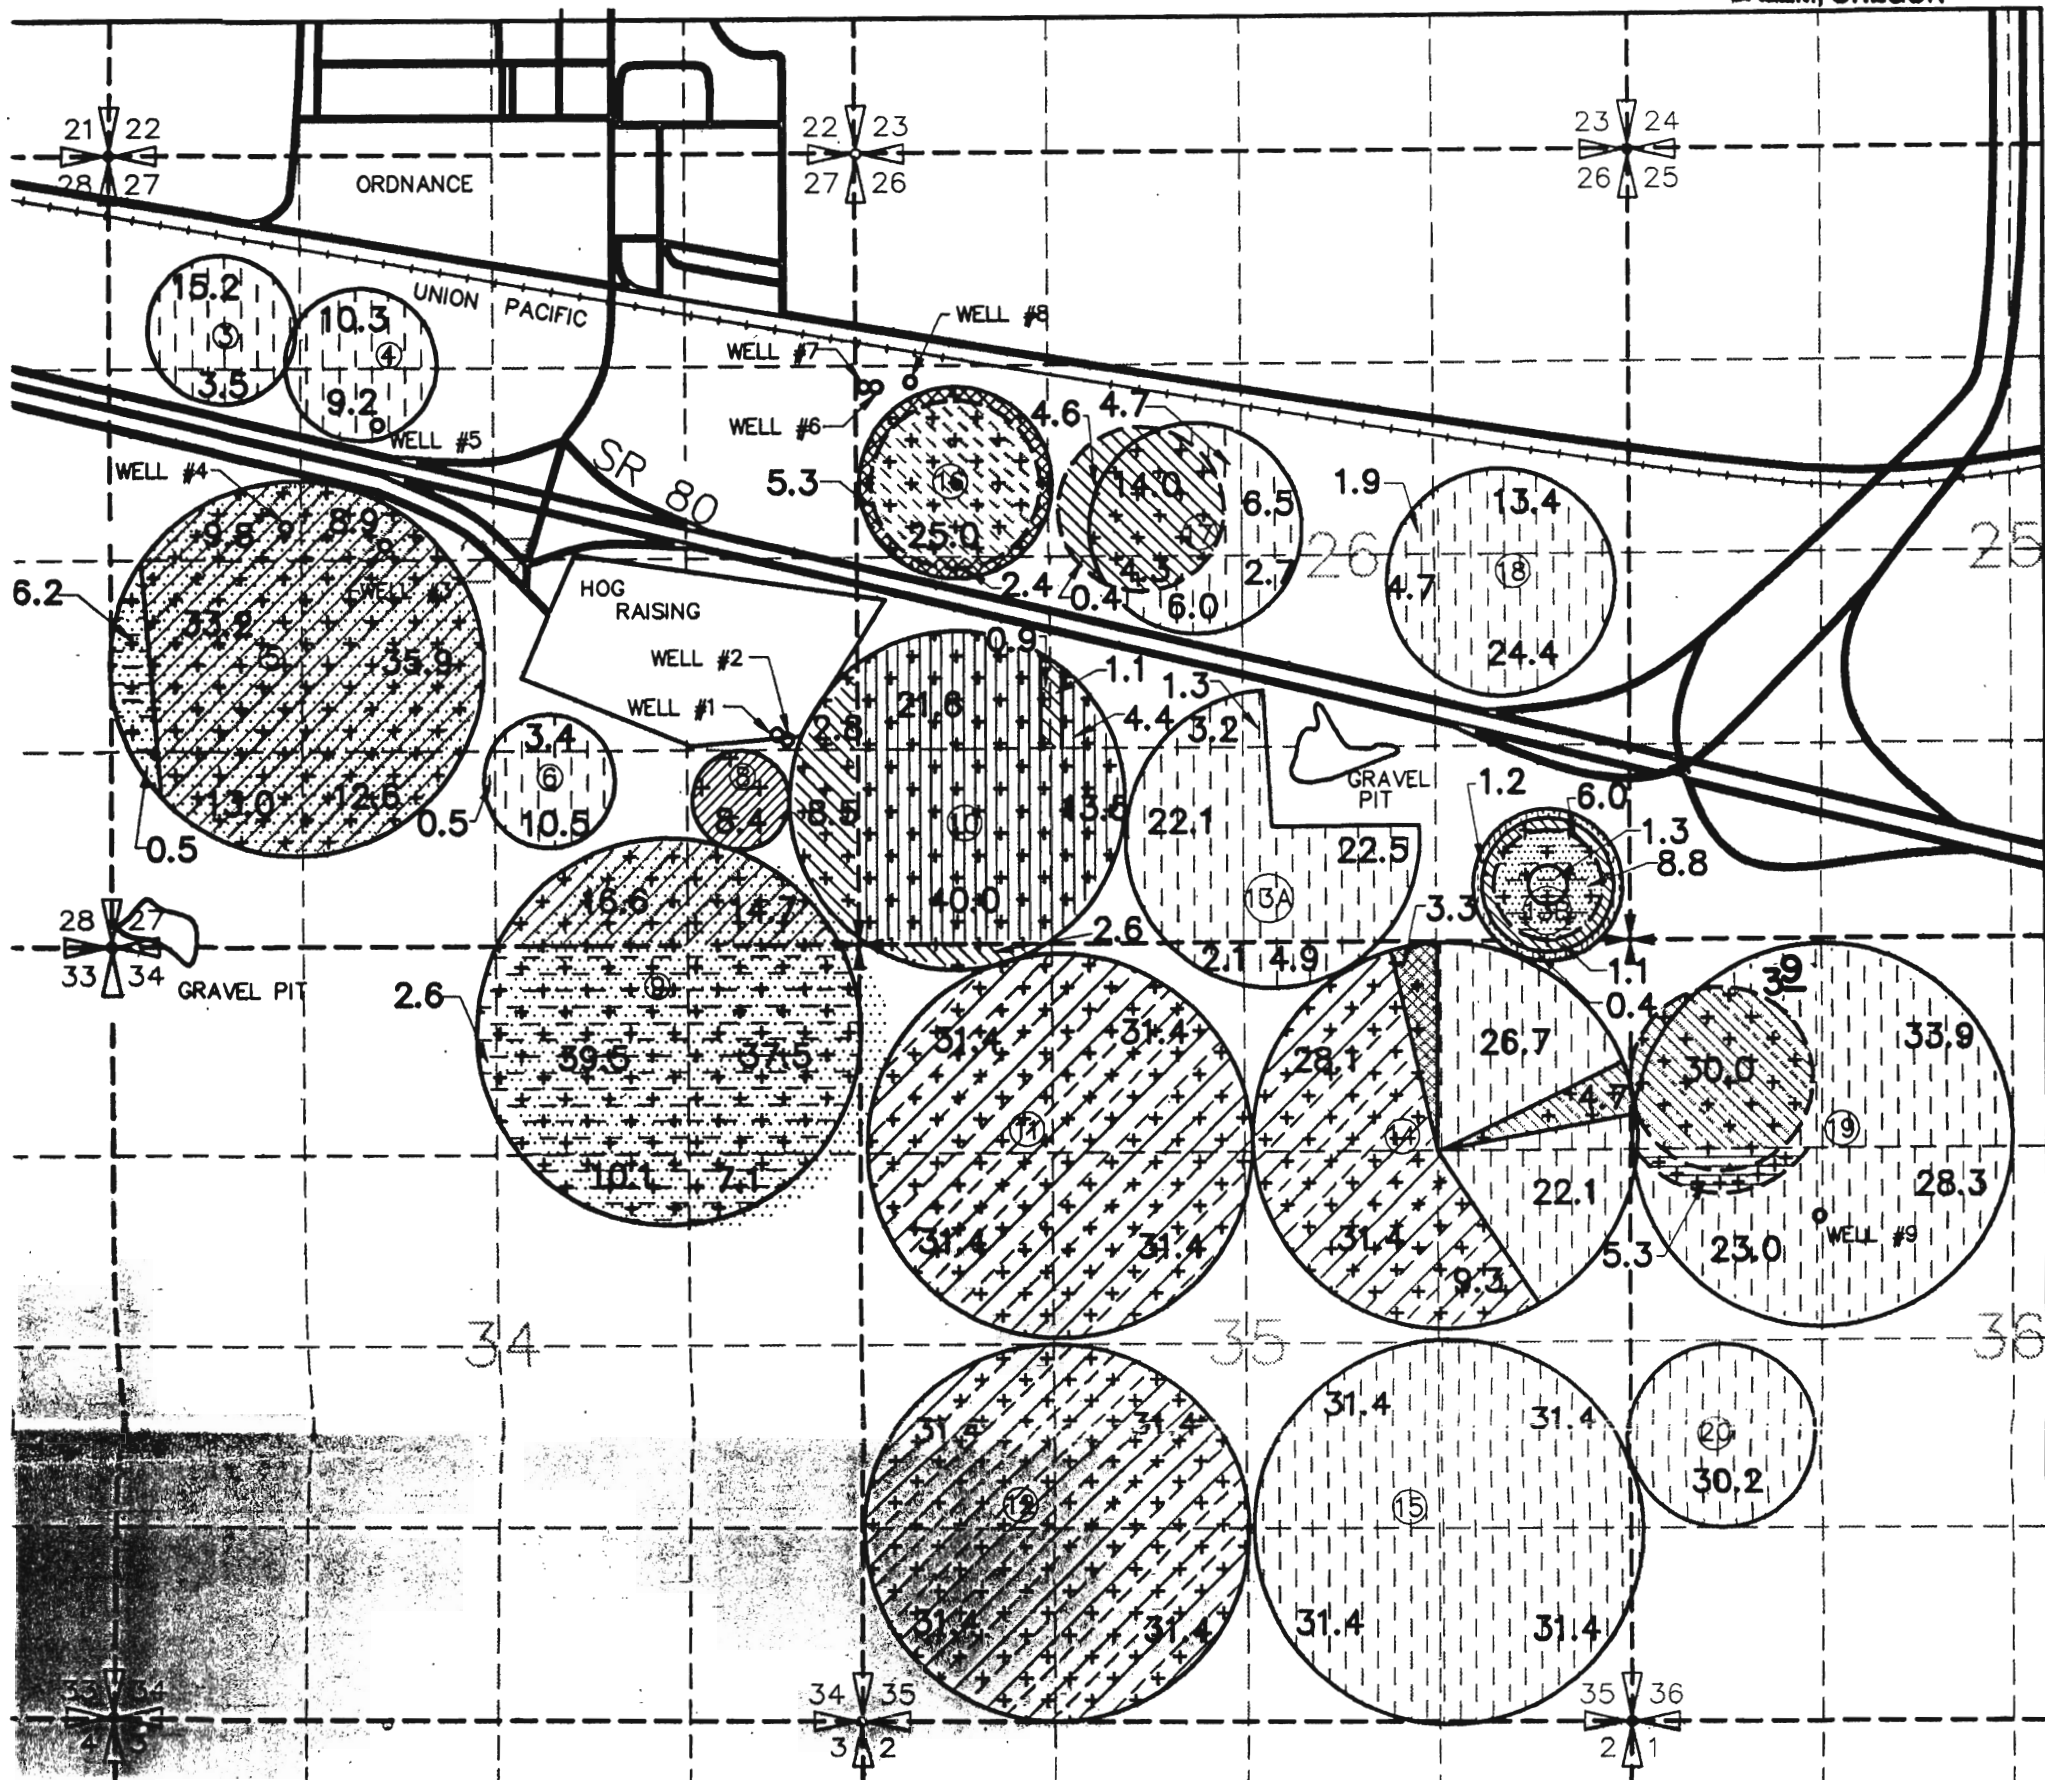


WELL 5 LOCATED 960'N & 1850'E FROM W¹/₄ COR. SEC.27 BEING WITHIN SE¹/₄NW¹/₄
WELL 6,7 LOCATED 1130'N & 60'E FROM W¹/₄ COR. SEC.26 BEING WITHIN SW¹/₄NW¹/₄
WELL 8 LOCATED 1160'N & 370'E FROM W¹/₄ COR. SEC.26 BEING WITHIN SW¹/₄NW¹/₄
WELL 9 LOCATED 1884'S & 1315'E FROM NW COR. SEC.36 BEING WITHIN SW¹/₄NW¹/₄

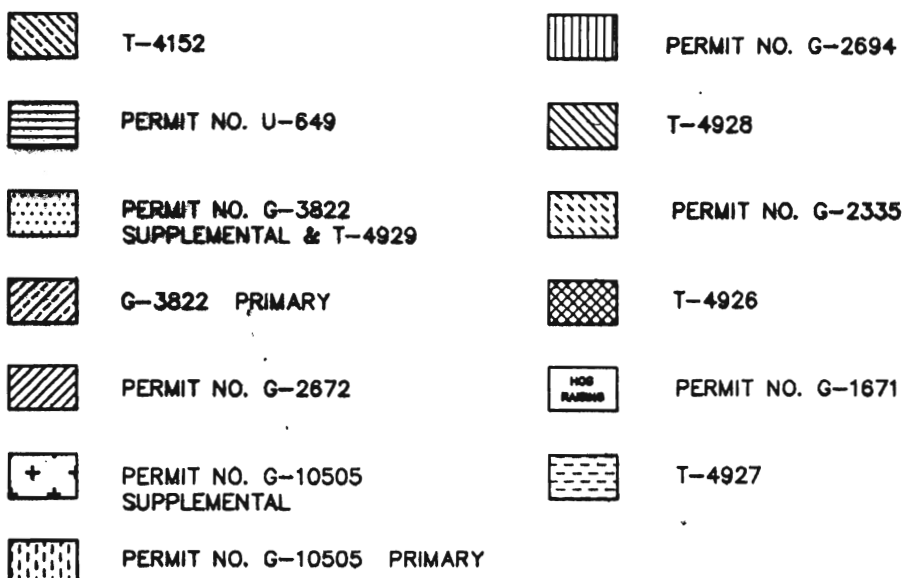

① CIRCLE NUMBER

31.4 IRRIGATED ACREAGE

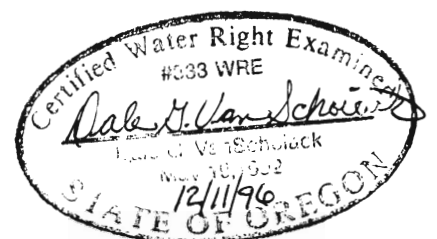

0' 1320' 2640'


NOTE: THE PURPOSE OF THIS MAP IS TO IDENTIFY THE APPROXIMATE LOCATION OF THE WATER RIGHT. IT IS NOT INTENDED TO PROVIDE INFORMATION RELATIVE TO THE LOCATION OF PROPERTY OWNERSHIP BOUNDARY LINES.

3522.016
CHANCELLA DWG
NOVEMBER 18, 1966


FINAL PROOF HANSELL BROTHERS INC.

T-7496, T-7497, T-7498, T-7499

T. 4N., R.27E., W.M.

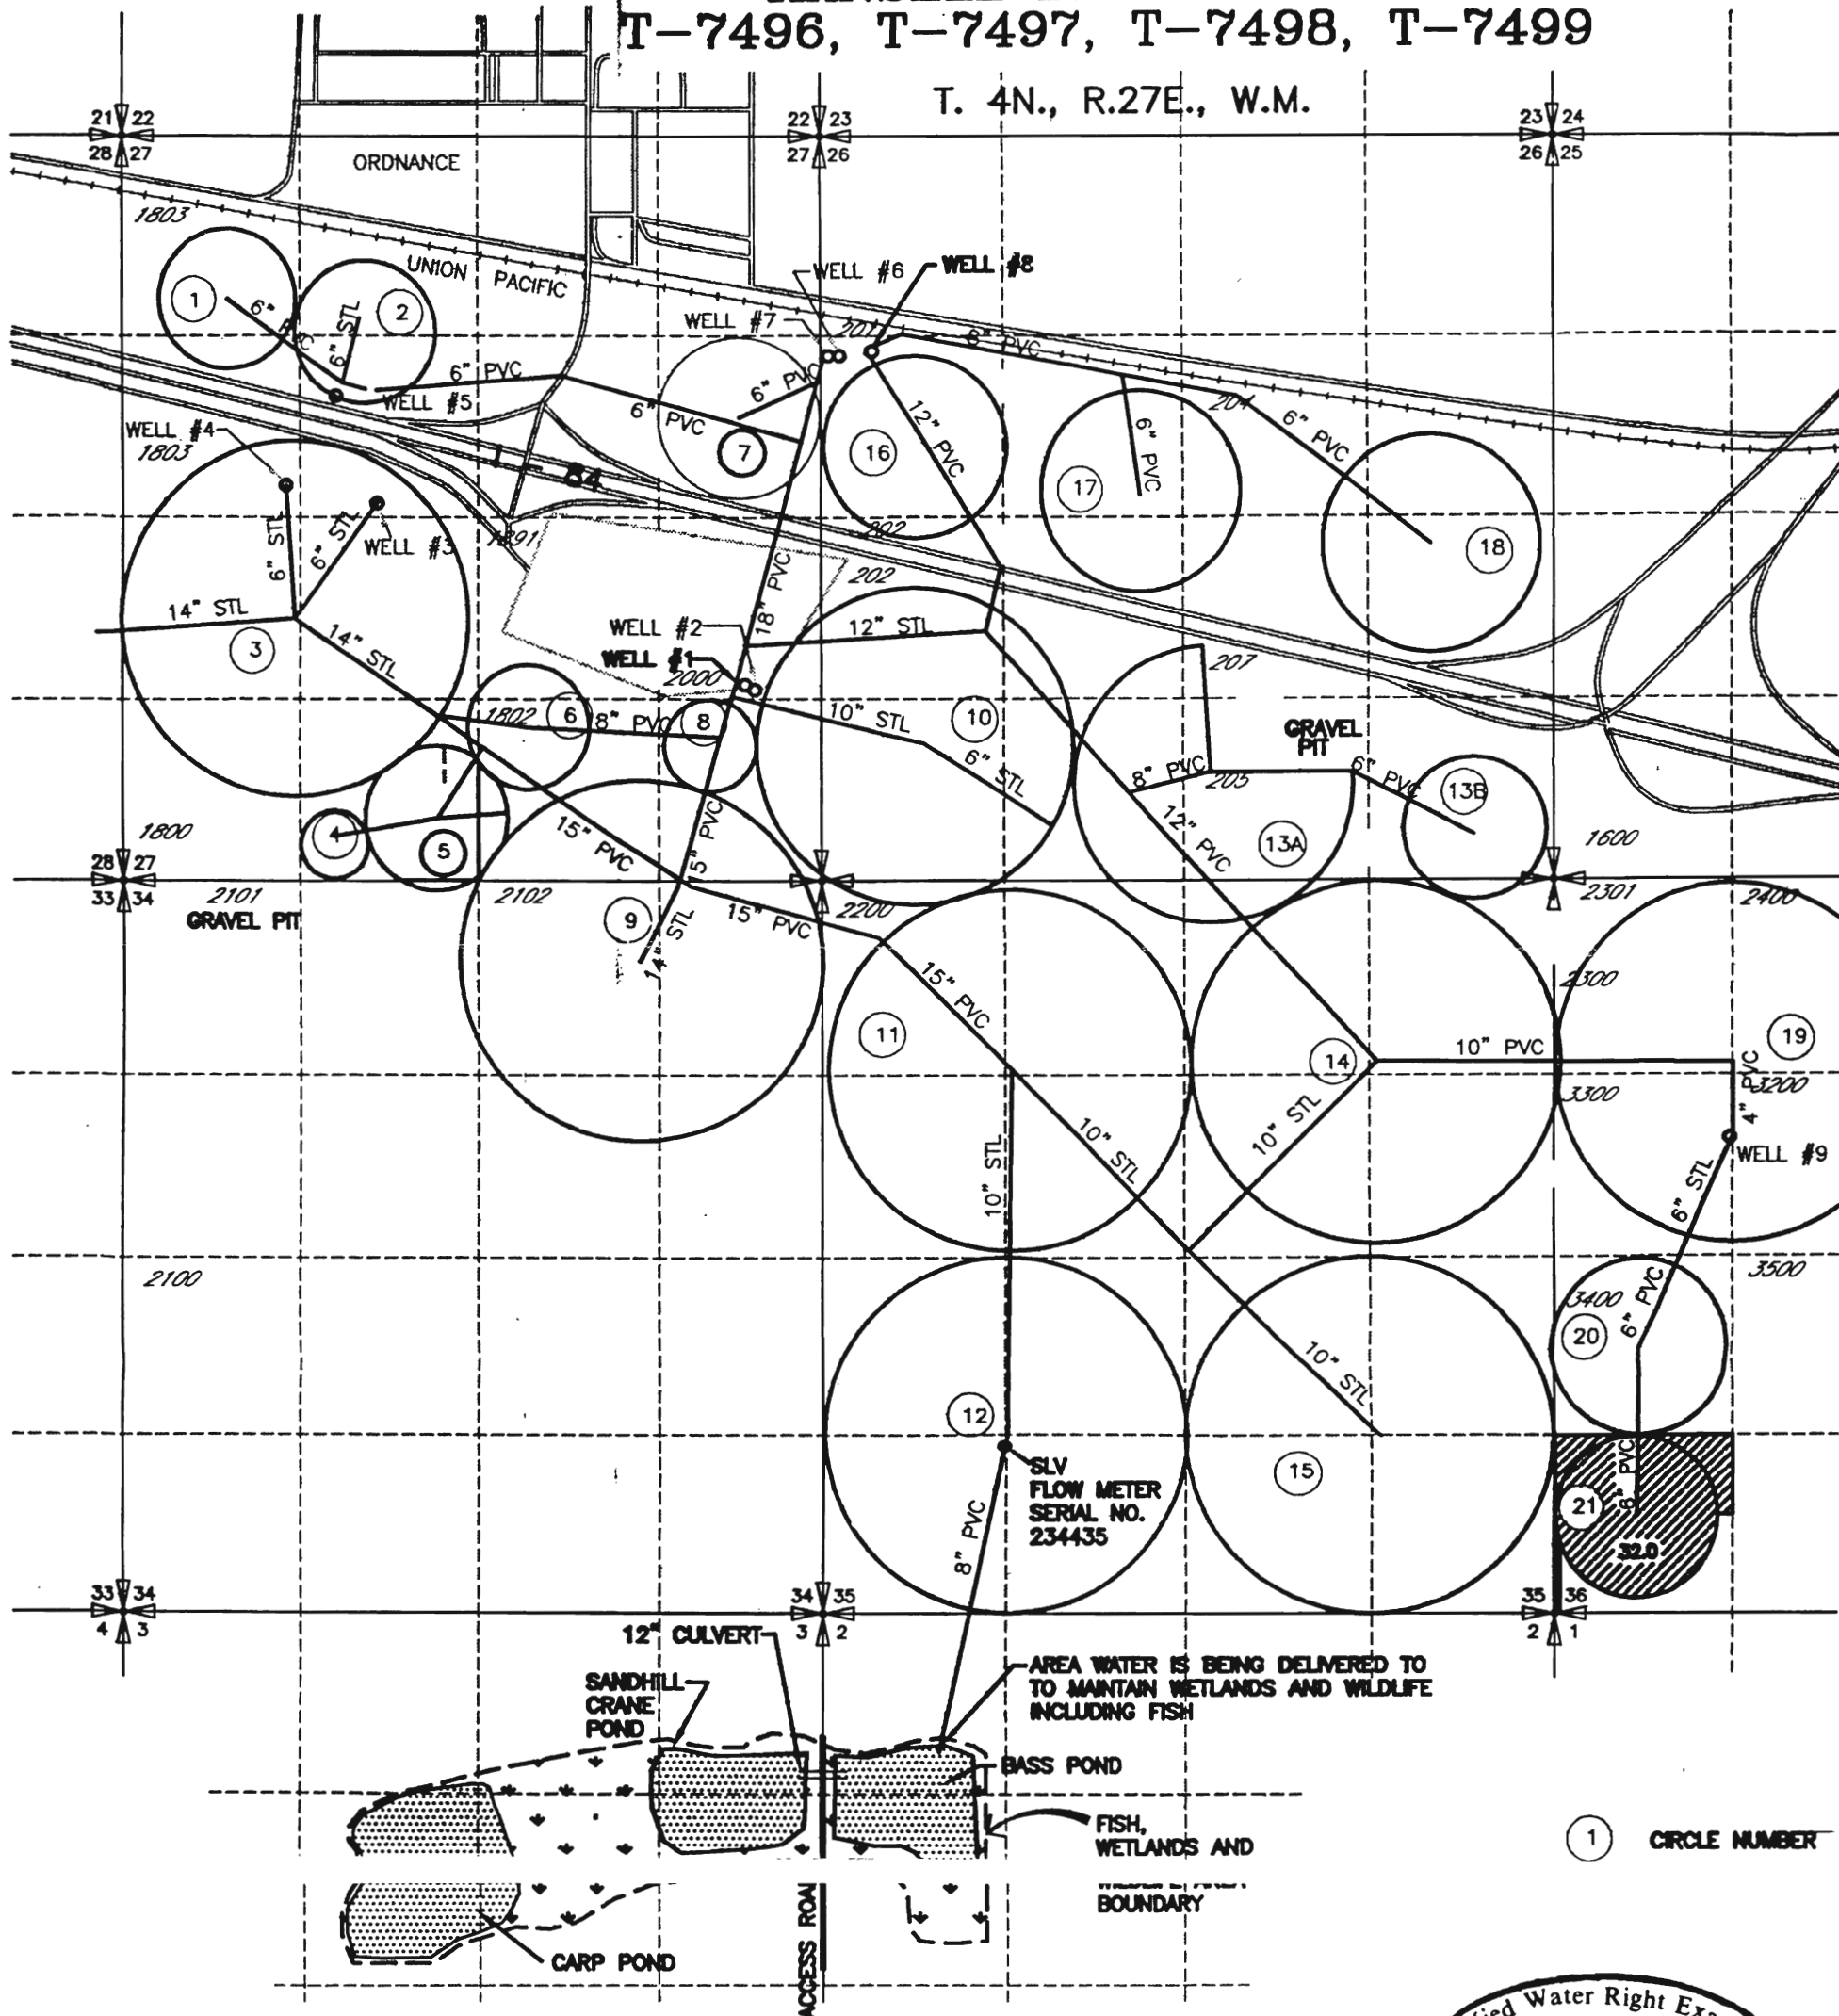

1 CIRCLE NUMBER

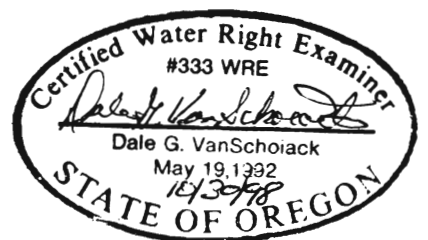

AREA FOUND IRRIGATED UNDER
UNDER T-7496, T-7497

AREA FOUND TO BE PONDS AND WETLANDS
UNDER T-7498, T-7499

NOTE: THE PURPOSE OF THIS MAP IS TO IDENTIFY THE APPROXIMATE LOCATION
OF THE WATER RIGHT. IT IS NOT INTENDED TO PROVIDE INFORMATION
RELATIVE TO THE LOCATION OF PROPERTY OWNERSHIP BOUNDARY LINES.