



FINAL PROOF SURVEY
 CLAIM OF BENEFICIAL USE
 SEC 32, 33, AND 34, T28S, R6W, W. M.
 SEC 3 AND 4, T29S, R6W, W. M.
 WATER RIGHTS TRANSFER T-6708
 FOR ROSEBURG FOREST PRODUCTS

PLACE OF USE 



SEPTEMBER 20, 2001

SCALE: 1" = 1320'

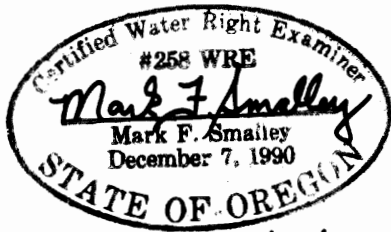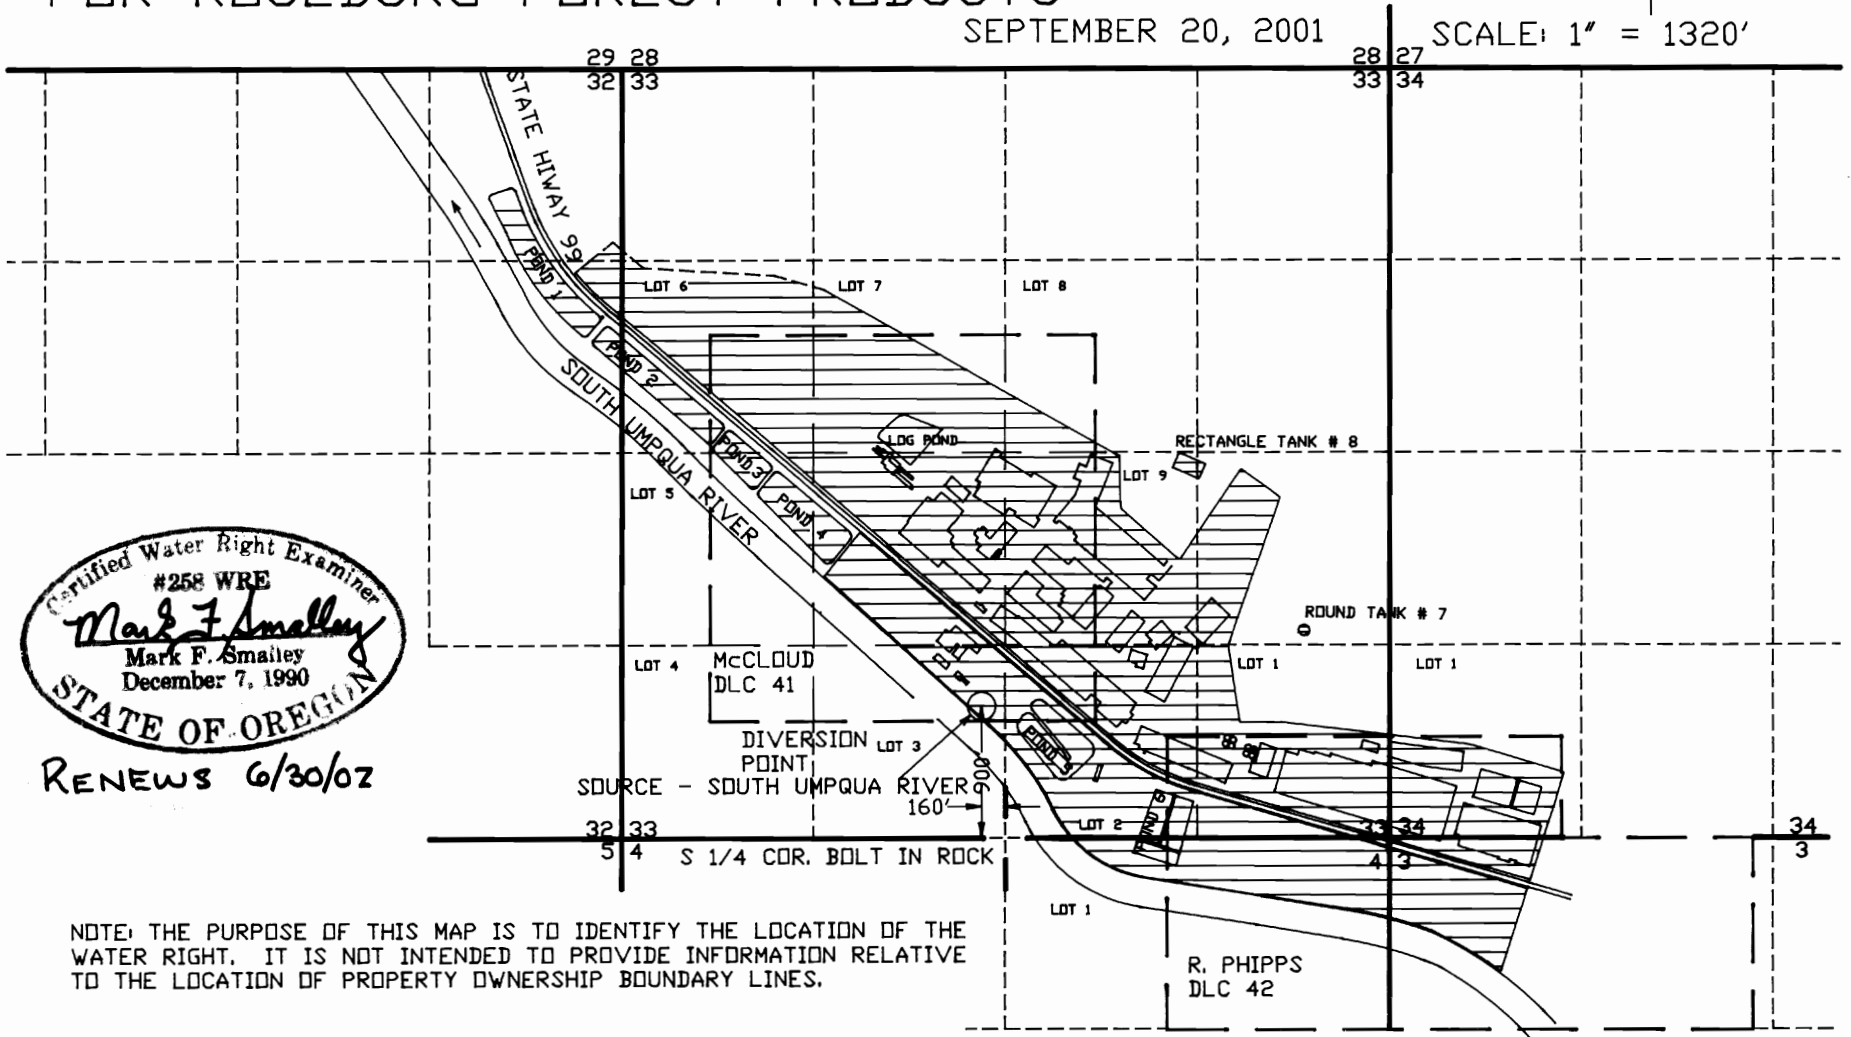

RENEWS 6/30/02

NOTE: THE PURPOSE OF THIS MAP IS TO IDENTIFY THE LOCATION OF THE WATER RIGHT. IT IS NOT INTENDED TO PROVIDE INFORMATION RELATIVE TO THE LOCATION OF PROPERTY OWNERSHIP BOUNDARY LINES.