


T.29S. R.4W. W.M.

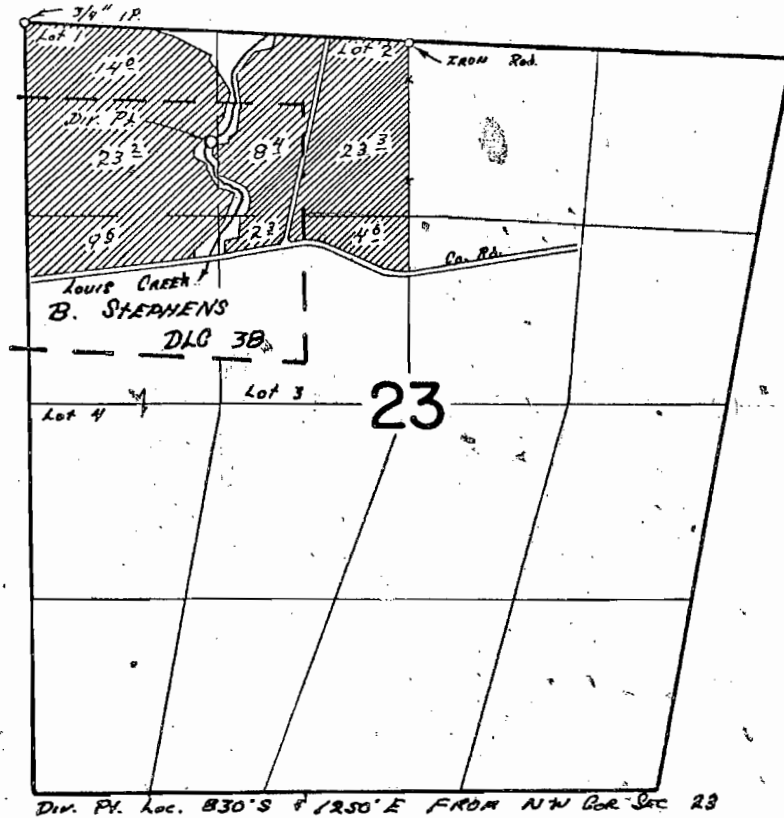

FINAL PROOF SURVEY
UNDER

TRANSFER No. M-123
Application No. _____ Permit No. _____
IN NAME OF

MRS. F. A. MOAN

Surveyed Oct. 14, 1966, by V. BARNER


RECEIVED

FEB. 11 2002

WATER RESOURCES DEPT.
SALEM, OREGON

T. 9030

T.29S. R.4W. W.M.

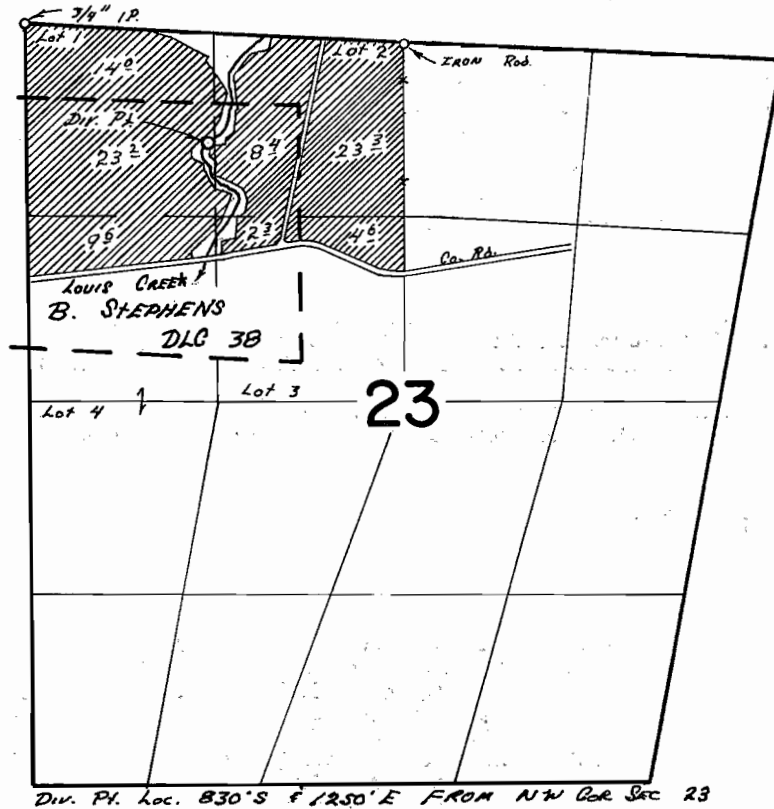

FINAL PROOF SURVEY UNDER

TRANSFER No. M-123
Application No. _____ Permit No. _____
IN NAME OF
MRS. F. A. MOAN

Surveyed Oct. 14 1966, by V. BARNER