


T. 3N., R. 29E., W.M.

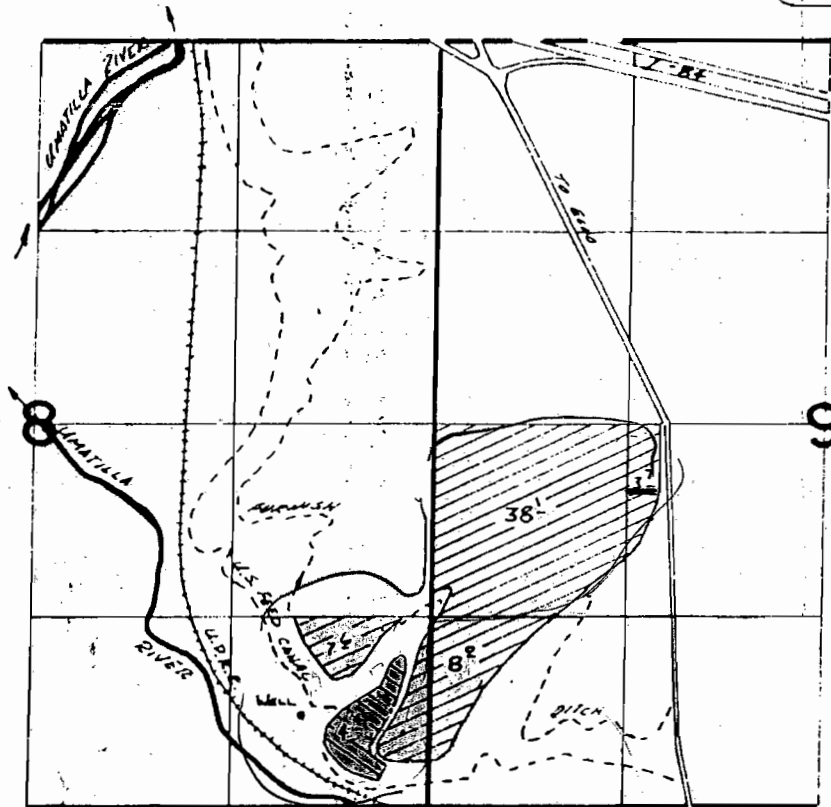

WELL LOC: 650' N. P. 870' W. FROM SE COR. SEC 8



PRIMARY



SUPPL. ?


FINAL PROOF SURVEY
UNDER

PRELIMINARY
SUBJECT TO REVISION

Application No. G:6681 Permit No. G:6233
IN NAME OF

KENNETH CLARK BOWMAN SR.

Surveyed April 13, 1983, by T. L. Church

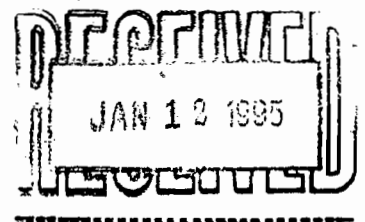



STANFIELD IRRIGATION DISTRICT
P. LAPP TO P. LAPP
TRANSFER MAP UNDER O.R.S. 540.580

RECEIVED

FEB 14 2002

WATER RESOURCES DEPT.
SALEM, OREGON

T3N R29E WM

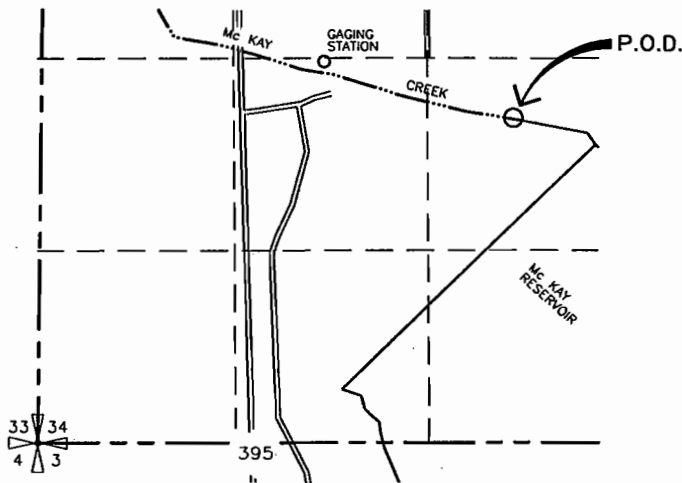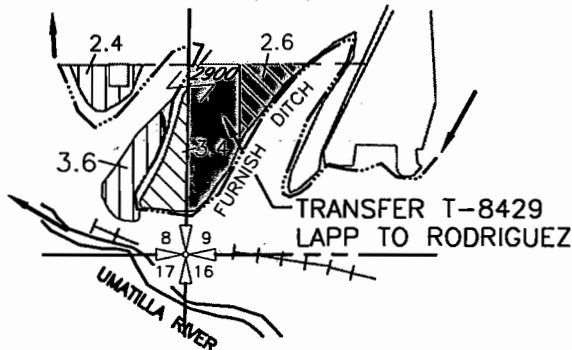


T2N R32E WM


P.O.D. McKay RESERVOIR
NW 1/4 SE 1/4 SEC 34

T3N R30E WM

P.O.D. FURNISH DITCH
LOCATED 380' NORTH AND 650' EAST
FROM THE SW CORNER SEC 31

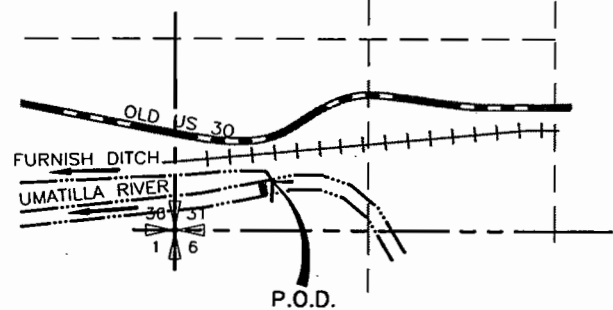


FROM

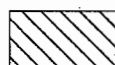

UMATILLA RIVER 8 MARCH 1905
AND McKay RESERVOIR JULY 7 1924

TO

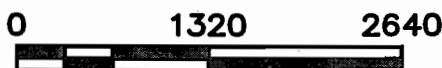

SCALE IN FEET

NOTE:
THE PURPOSE OF THIS MAP IS TO IDENTIFY THE APPROXIMATE LOCATION
OF THE WATER RIGHT. IT IS NOT INTENDED TO PROVIDE INFORMATION
RELATIVE TO THE LOCATION OF PROPERTY OWNERSHIP BOUNDARY LINES.

T-9032