


RECEIVED

APR 21 1998

T. 2 S., R. 26 E., W.M.  
MORROW COUNTY, OREGON

WATER RESOURCES DEPT  
SALEM, OREGON

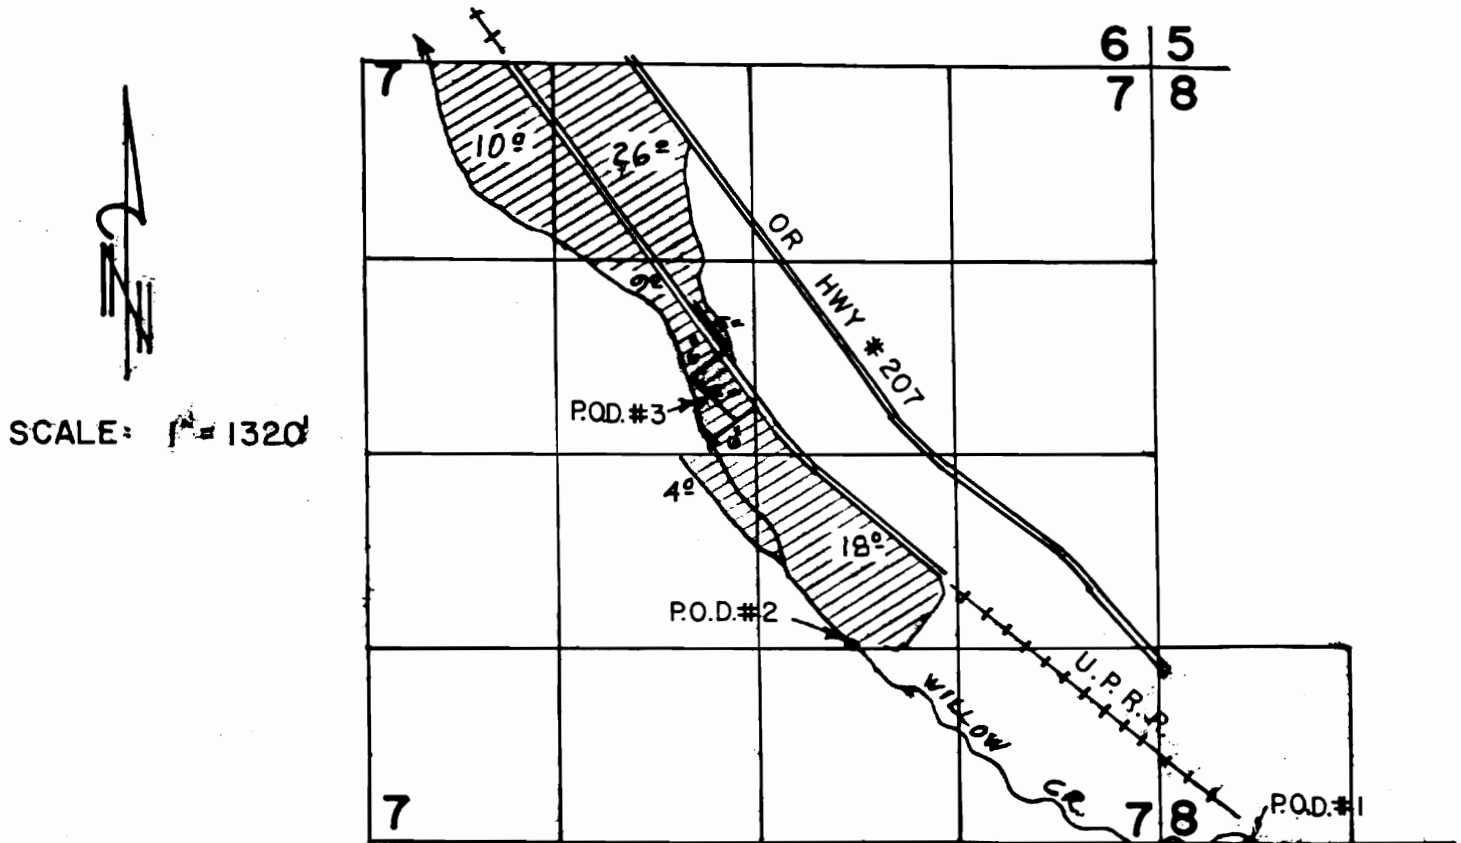

- P.O.D. #1 60' N & 600' E of SW Corner of Section 8.
- P.O.D. #2 1370' N & 2050' W of SE Cor. of Section 7.
- P.O.D. #3 2350' S & 3040' W of NE Cor. of Section 7.

FINAL PROOF SURVEY

UNDER

TRANSFER-6743

IN NAME OF

ALBERT L. OSMIN

The preparation of this map is for the purpose of identifying the location of water rights only, and has no intent to provide dimensions or locations of property ownership lines.

