


RECEIVED

SEP 30 1998

WATER RESOURCES DEPT
SALEM, OREGON

T.5S. R.7W., W.M

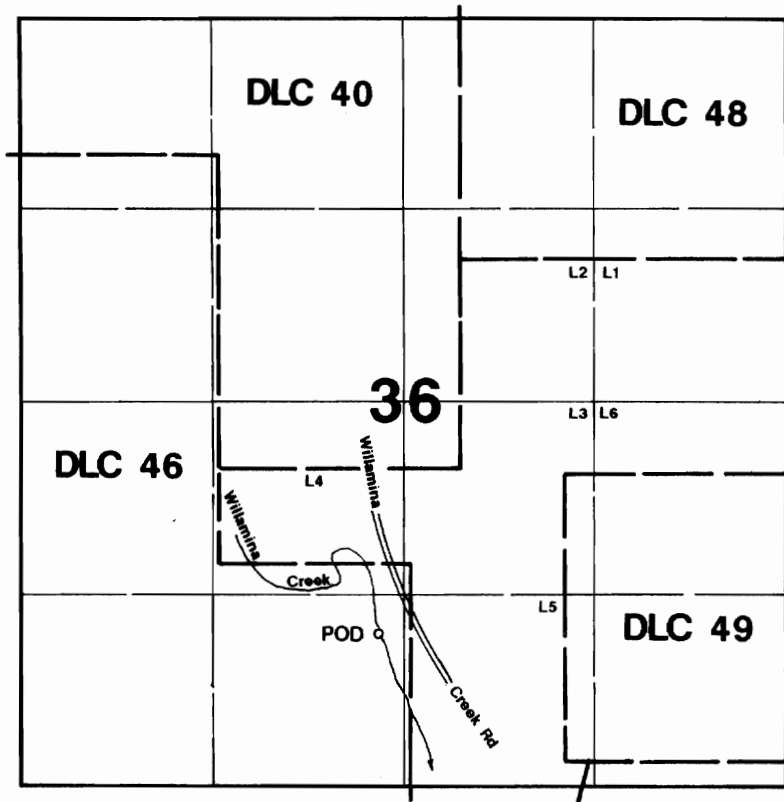

Point of Diversion is located 1050'N & 2480'E from SW corner Section 36.

Final Proof Survey

Transfer #: T-6752

In Name Of

City of Willamina

Surveyed on September 10, 1998 by JM Schuette

This Map Was Prepared For The Purpose Of Identifying The Location Of A Water Right Only And Is Not Intended To Provide Legal Dimensions Or Location Of Property Ownership Lines.

