


1-61760

Township 6 South, Range 1 East, W. M.


Portions of Sections 8 & 17

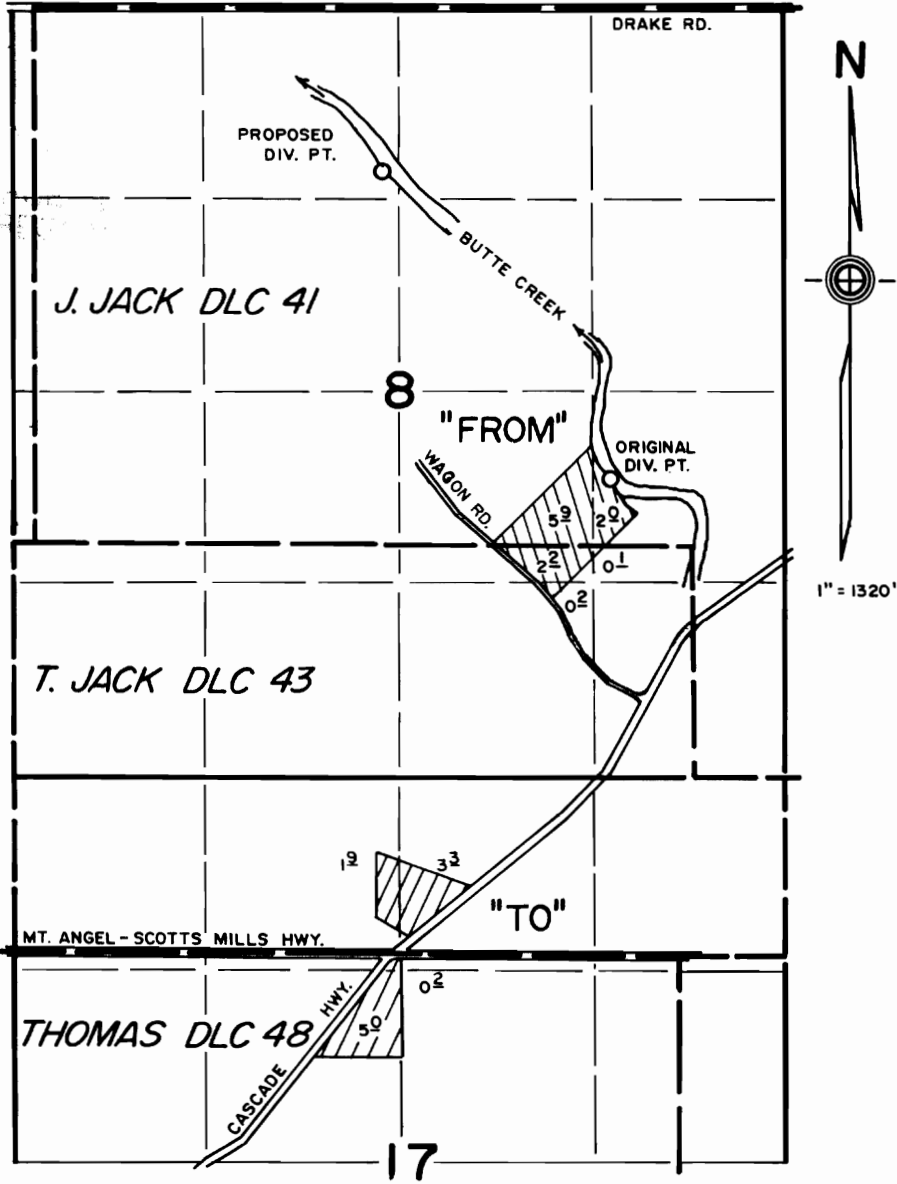

ORIGINAL DIV. PT. LOCATED 520' N. & 520' W. FROM NE COR. DLC 43
PROPOSED DIV. PT. LOCATED 1130' S. & 100' W. FROM N. 1/4 COR. SEC. 8

Trans. No. _____

Map to Accompany
Transfer Application
in the name of
KRAEMER FARMS

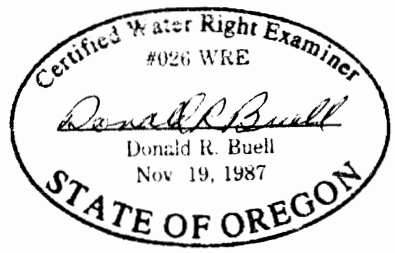

THIS MAP WAS PREPARED FOR THE PURPOSE OF IDENTIFYING THE LOCATION OF A WATER RIGHT ONLY AND IS NOT INTENDED TO PROVIDE LEGAL DIMENSIONS OR LOCATION OF PROPERTY OWNERSHIP LINES.