



T. 1S. R. 2W., W.M.

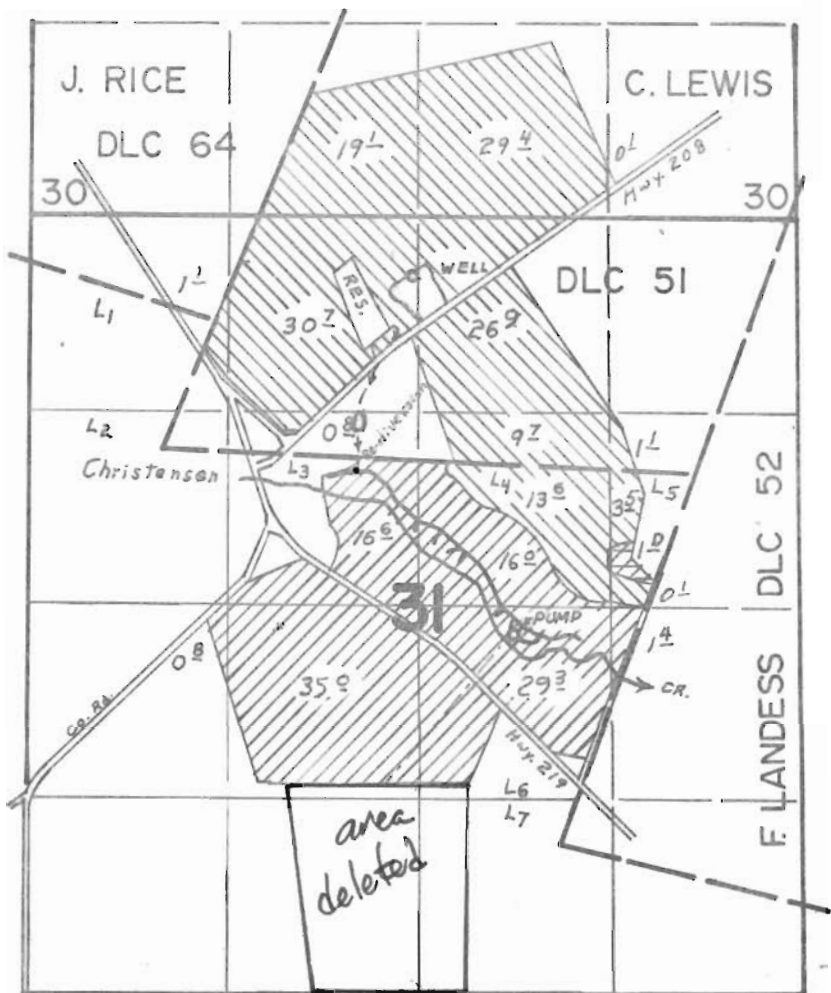

Well: 420'S of 2650', Reservoir: 880'S of 2350'E, Re-diversion: 1750'S of 2290'E, Pump: 2850'S of 3360'E all from NW corner Section 31

Permits R-6128 & 37849
(supplemental)

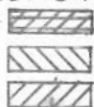

Permit G-5692 Primary

Permit - G-5692 Supplemental

FINAL PROOF SURVEY UNDER

G-5800
R-53059

G-5692
R-6128

Application No. 53060... Permit No. 37849...
IN NAME OF

OREGON BERRY PACKING CO.

Surveyed JUNE 21, 22, 1978, by S. P. APPLIGATE