


**FINAL PROOF SURVEY
UNDER T-6787 ECHO IRRIGATION
DISTRICT FOR
RICK & DOUGLAS HALE
T3N, R29E, WM**

RECEIVED
NOV 21 2004
WATER RESOURCES DIVISION
SALEM, OREGON

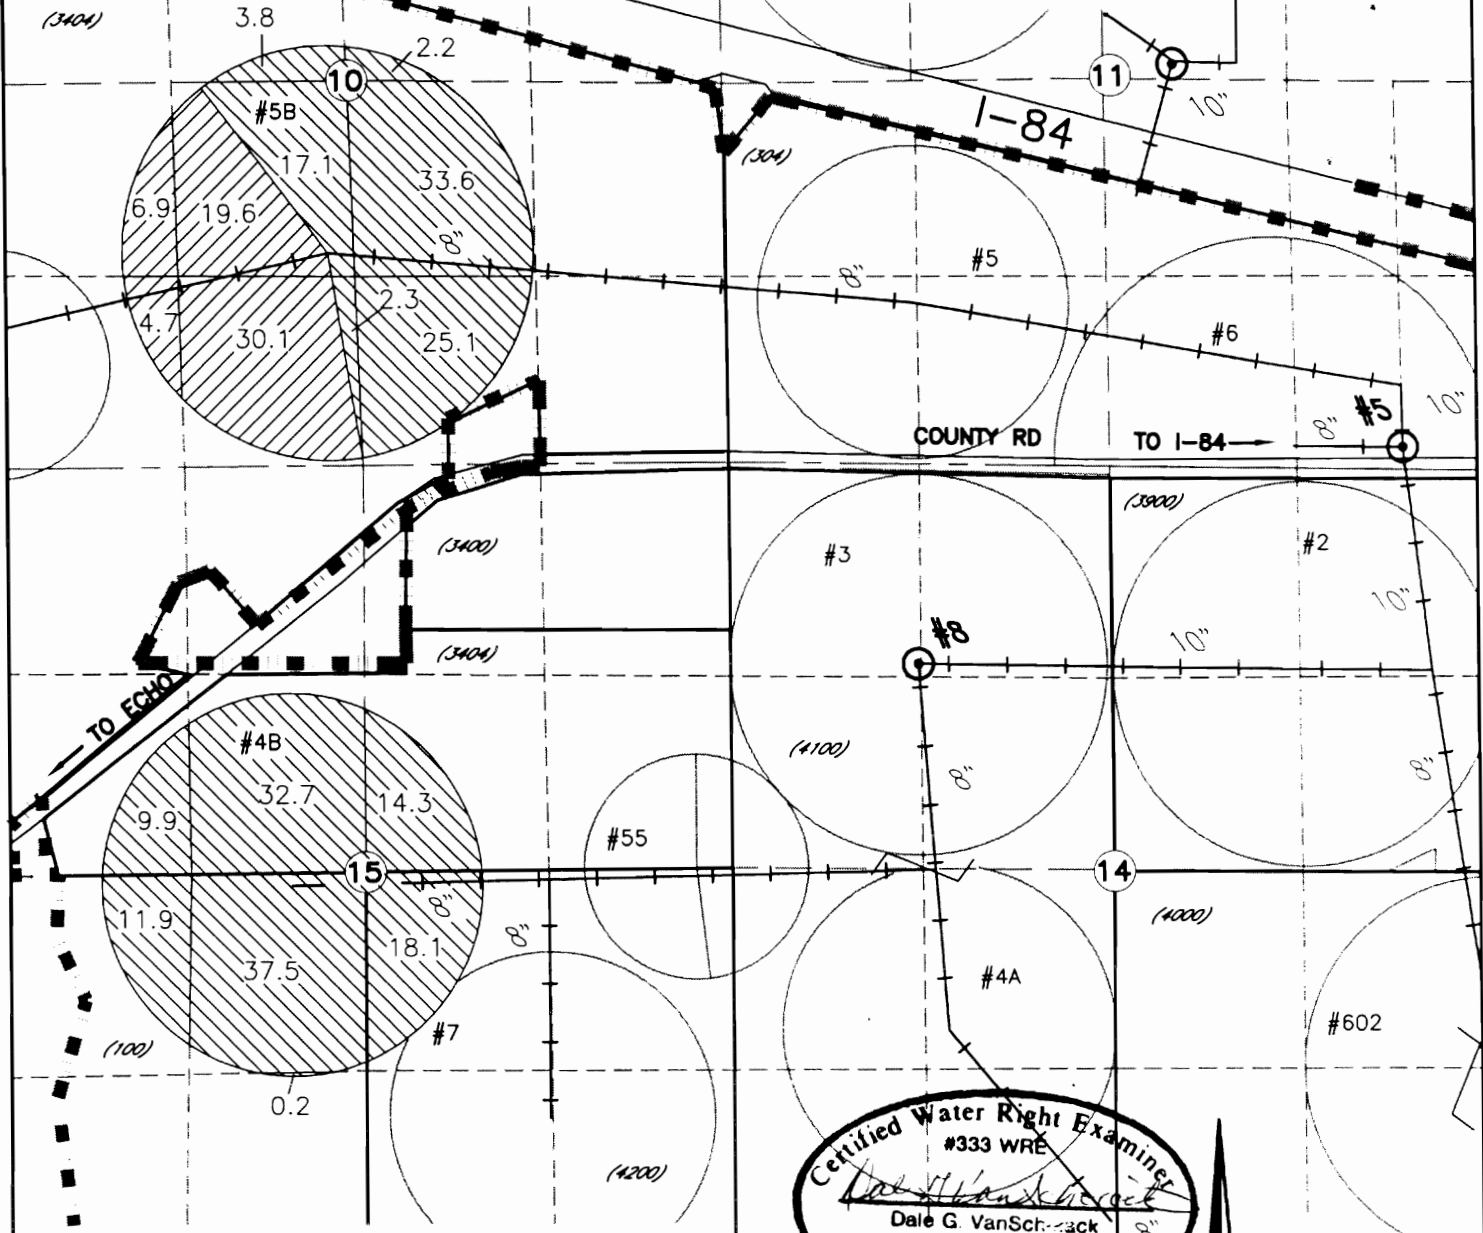


**AUTHORIZED POINT OF APPROPRIATION
HALE WELL NO #5
LOCATED 60'N + 590'W FROM SE COR, SEC 11**

- AREA OF USE**
- 61.3 Ac PRIMARY PERMIT G-2415
SUPPLEMENTAL PERMIT G-4969
 - 208.7 Ac PRIMARY PERMIT G-4969

- LEGEND**
- 8" PIPE SIZE
 - #7 CIRCLE NUMBER
 - #5 HALE'S WELL #5
 - (4000) TAX LOT

Certified Water Right Examiner
#333 WRE
Dale G. VanSchick
Dale G. VanSchick
May 19, 1992
1927/04
STATE OF OREGON

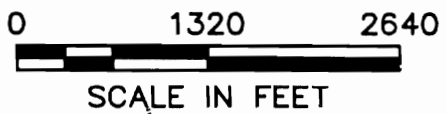

NOTE: THE PURPOSE OF THIS MAP IS TO IDENTIFY THE APPROXIMATE LOCATION OF THE WATER RIGHT. IT IS NOT INTENDED TO PROVIDE INFORMATION RELATIVE TO THE LOCATION OF PROPERTY OWNERSHIP BOUNDARY LINES.



DRAWING: H:\CAD\AG\3522\032\3522032FP6787.dwg
PRINTED BY: RogerW on 10/26/04 06:46 AM