
TRANSFER T-7067 FINAL DRAWING

This drawing has been prepared in accordance with the items listed on the letter dated may 18, 2004 to Lester E. Fultz, CWRE and Steven F. Kellow in reference to the subject Transfer written by Dorothy I. Pedersen, Water Rights Specialist.

The Items are plus action taken is:

- 1. The location of the authorized Place of Use has been verified.
- 2. The location of the two domestic uses has been shown on the drawing.
- 3. The general location of the proposed water delivery lines is shown.
- 4. The location of Highway 22, 3 Rivers and Lawrence Creek are shown.
- 5. The approximate property lines have been shown.
- 6. The scale of the Final Proof Map is 1-inch = 400-feet.

This drawing was prepared for Steven F. Kellow for Transfer T-7067 for the property located 38675 Highway 22, Hebo, Tillamook County, OR.

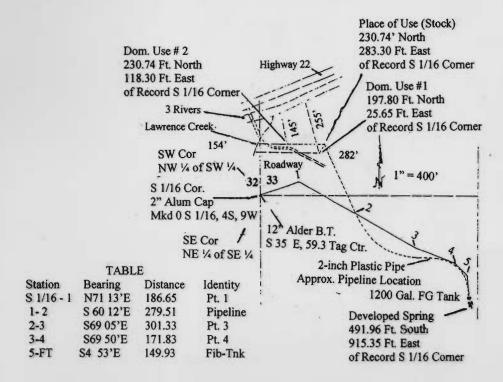



NOTES:

- 1. The water source is an un-named spring flowing into Lawrence Creek, a tributary of 3 Rivers, Tillamook County, Oregon.
- 2. The water flows through a protected pipe to a 1200-gallon fiberglass storage tank. The tank is in a covered enclosure with drain & overflow pipes with valves.
- 3. The bearing for this Survey was established by sighting the center of the tag & using record bearing scratched on the tag.