




T.4S. R.13E., W.M.

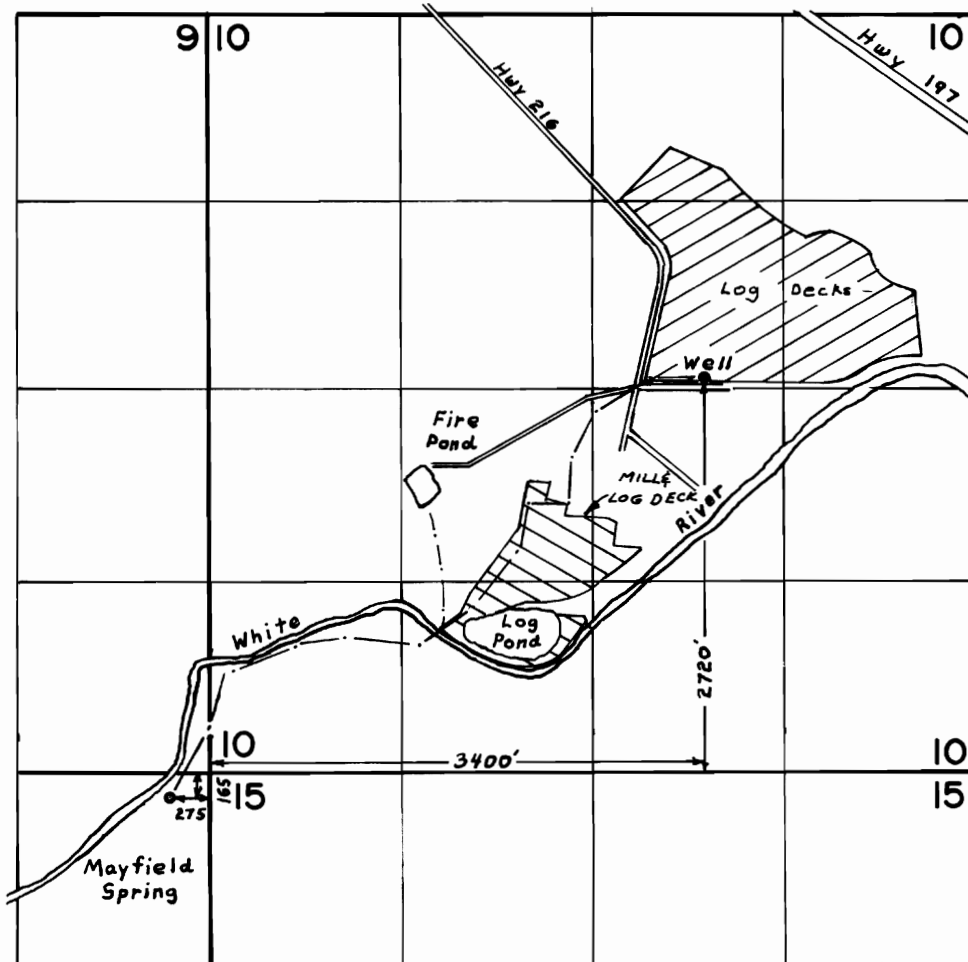

 App'l. 54579 & G-7453
 App'l. 49623 & Tr. 2691

FINAL PROOF SURVEY UNDER

Transfer No. 2691
 G-7453 G-6945
 49623 36160
 Application No. 54579... Permit No. 40955...
 IN NAME OF

...MOUNTAIN FIR LUMBER CO., INC.

Surveyed SEP. 14. 1977., by L.H. NUNN.....