



**AMENDED
FINAL PROOF MAP**
Section 24, T.33S. R.18E., W.M.
Lake County, Oregon
Transfer T-6801

SEE PLANS
WATER RESOURCES DEPT.
DALEM, OR

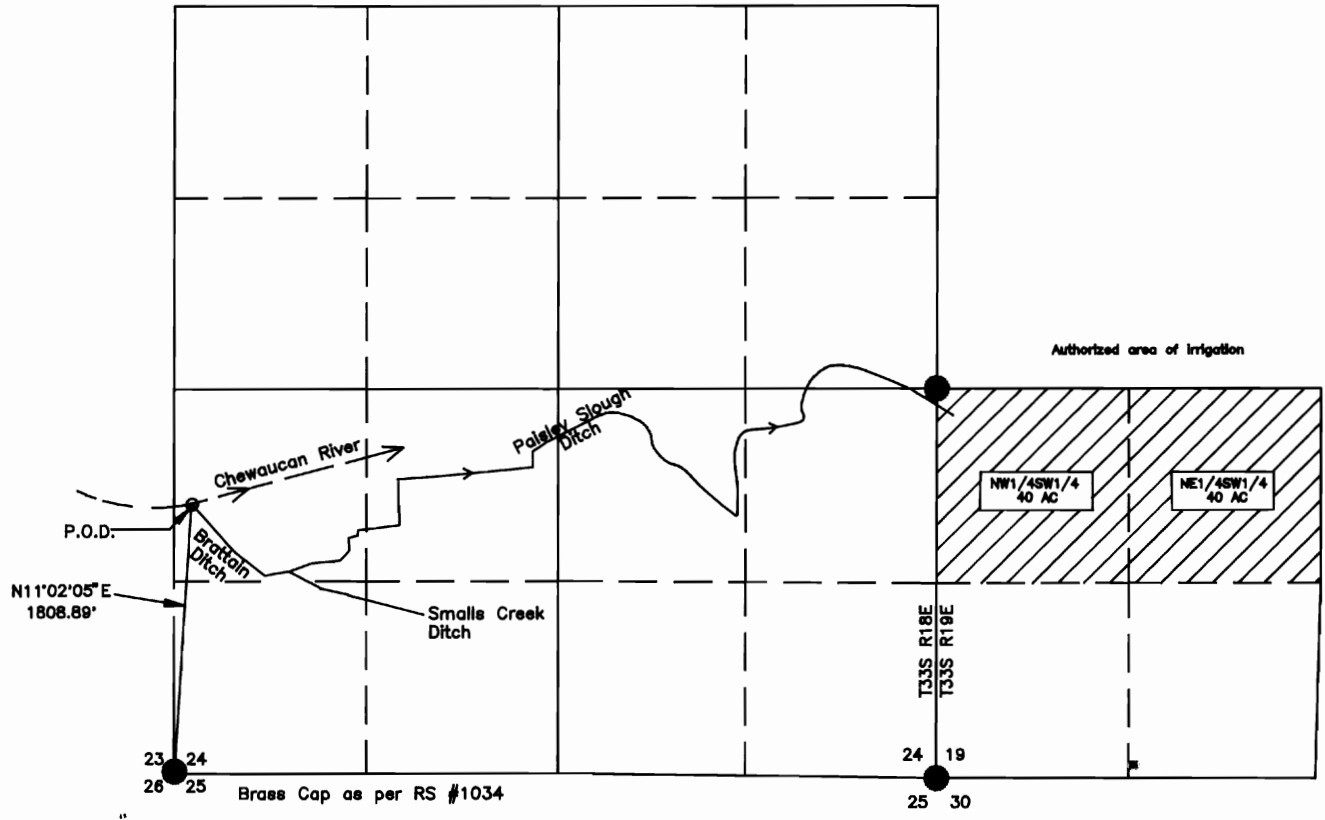

This map is for the purpose of identifying the location of the water right only and is not intended to provide legal dimensions or location of property lines.

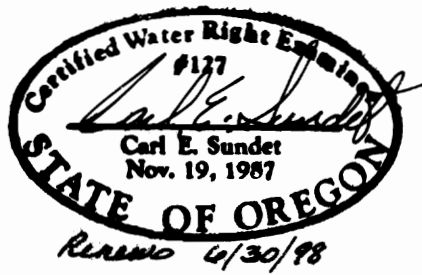

Survey for:
Survey by:

May 1997

Edward Murphy
Sundet & Associates
P.O. Box 1228
Lakeview, OR 97630
(541)947-3293
Drawing #8197