

RECEIVED

T13S R29E

FEB 11 1997


18 | 17

17 | 16

19 | 20

20 | 21

WATER RESOURCES DEPT.
SALEM, OREGON

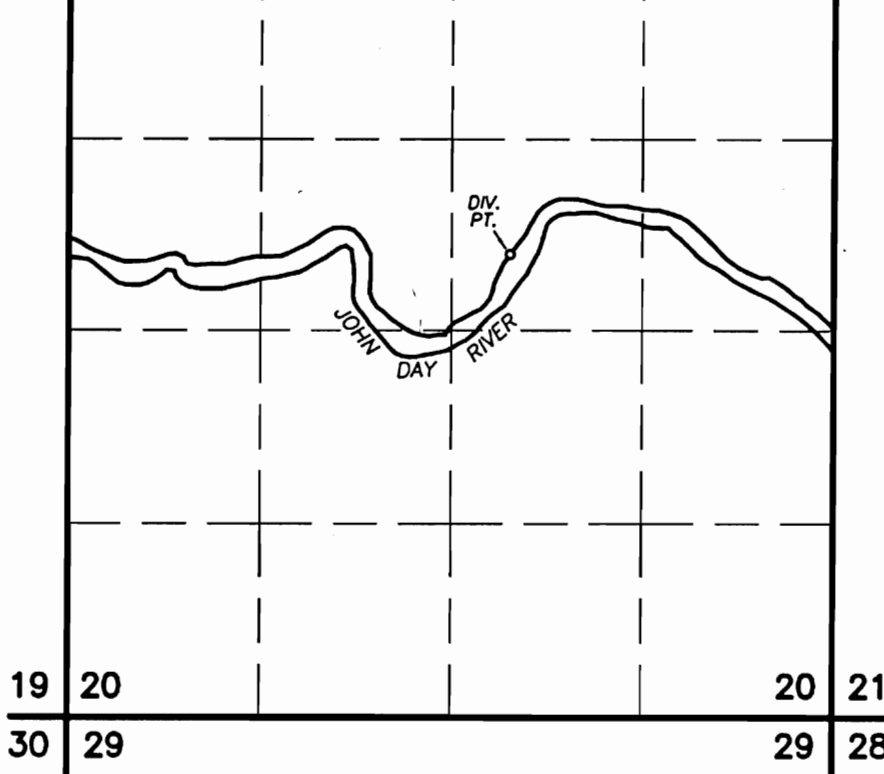

SCALE 1" = 1320'

DIV. POINT IS 2110' S. AND 2240' W. OF THE NE COR. OF SEC. 20

FINAL PROOF SURVEY
UNDER
T-6805

IN THE NAME OF
DAVID FAVRE

SURVEYED SEPT. 26, 1996 BY R.D. BAGETT

BAGETT-GRIFFITH & BLACKMAN
P.O. BOX 476
JOHN DAY, OR. 97845

NOTE: THE PREPARATION OF THIS MAP
WAS FOR THE PURPOSE OF IDENTIFYING
THE LOCATION OF THE PROPOSED WATER
RIGHT AND HAS NO INTENT TO PROVIDE
DIMENSIONS OR LOCATION OF PROPERTY
OWNERSHIP LINES.

