



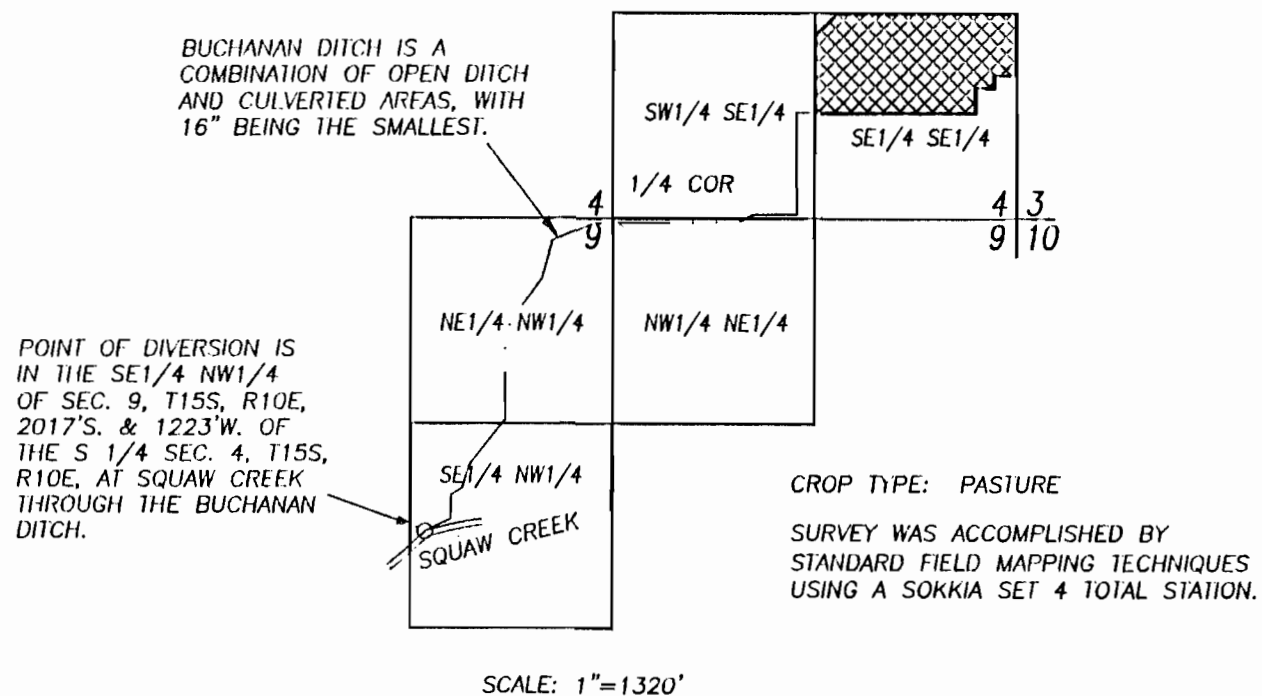

Revised 4/15/02
SQA

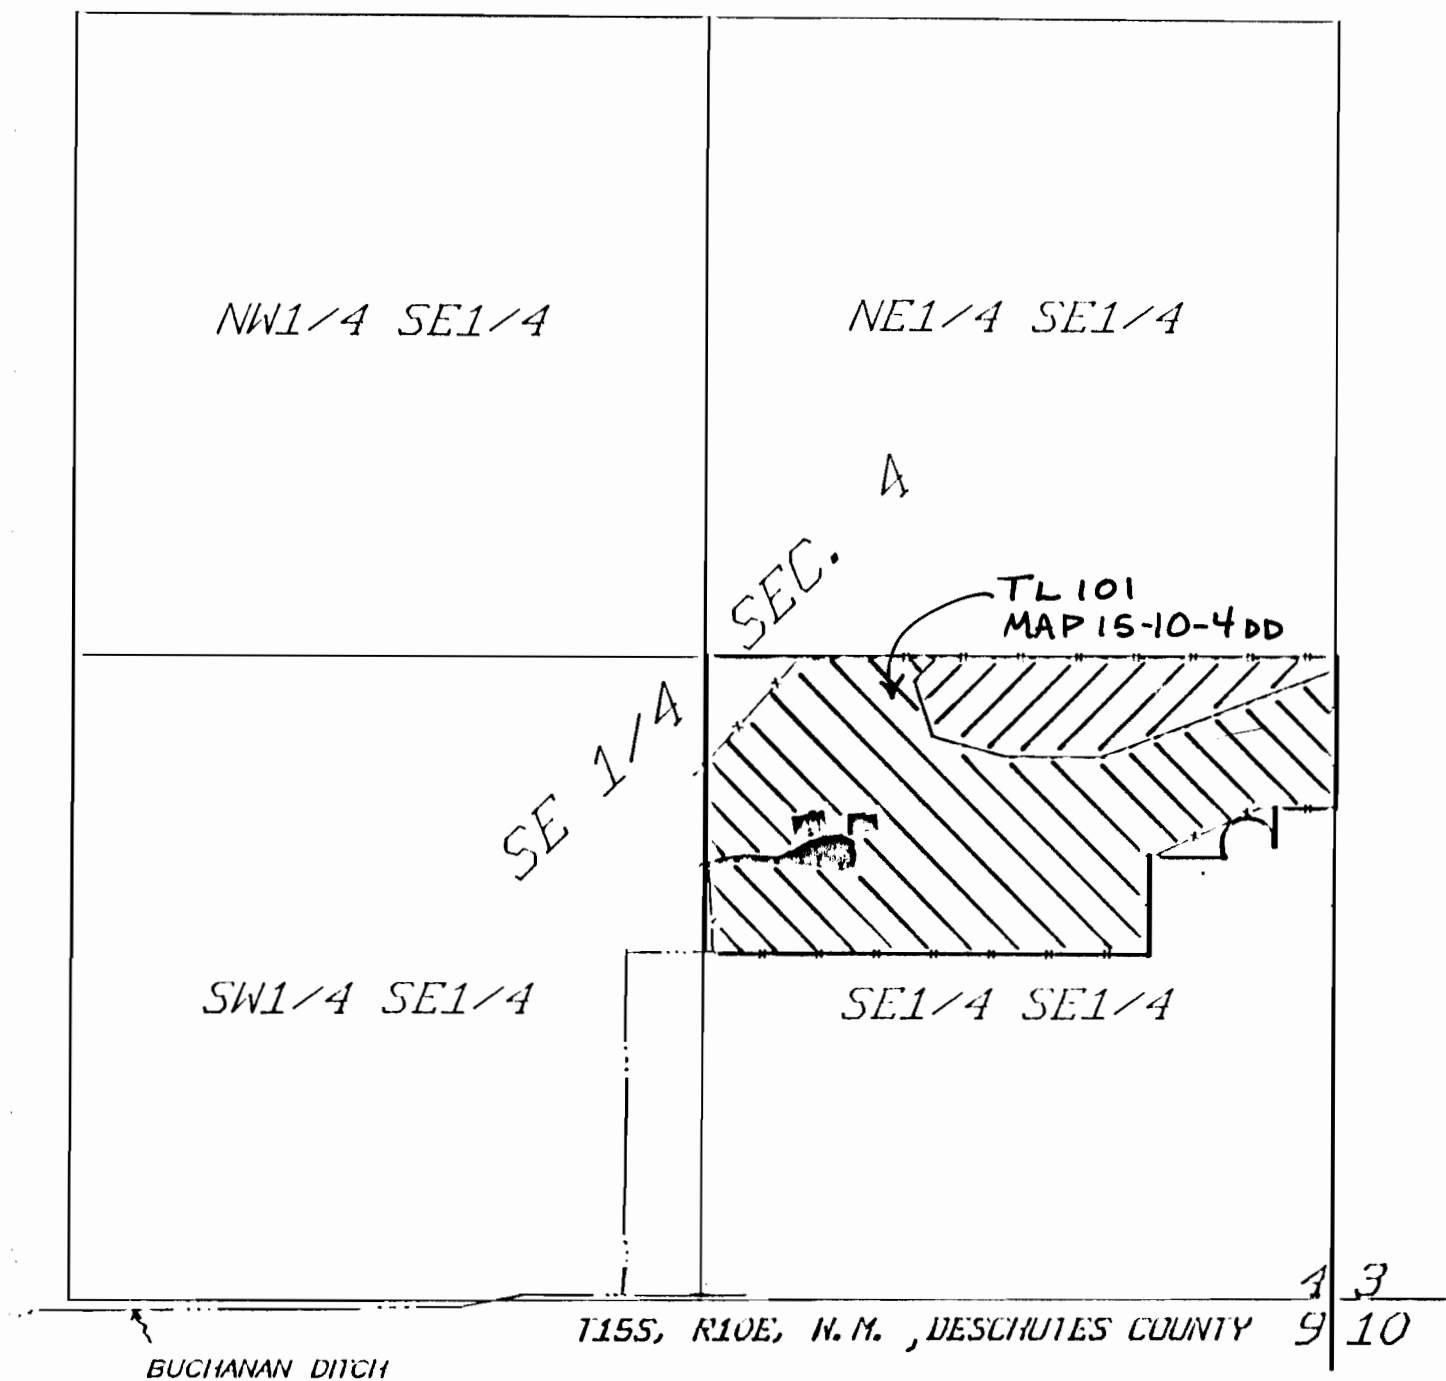

FINAL PROOF SURVEY

TRANSFER NO. 6608

IN THE NAME OF

JOHN T. TELIAN

THE PREPARATION OF THIS MAP IS FOR THE PURPOSE OF IDENTIFYING THE LOCATION OF THE WATER RIGHT ONLY AND HAS NO INTENT TO PROVIDE DIMENSIONS OR LOCATIONS OF PROPERTY OWNERSHIP LINES.

- ☒ 3.5 AC. 1883 EXISTING WATER RIGHTS
- ☒ TRANSFER ON 11.6 AC. 1883 WATER RIGHTS



1" = 400'

