

LOCATED IN THE NORTHEAST ONE QUARTER OF SECTION 27, TOWNSHIP 27 SOUTH, RANGE 17 EAST, W.M. LAKE COUNTY OREGON


FOUND REFERENCE MONUMENT AT THE EAST ONE QUARTER CORNER OF SECTION 27.

# FINAL PROOF SURVEY AND CLAIM OF BENEFICIAL USE

## UNDER TRANSFER 6614 CHANGE IN POINT OF APPROPRIATION ONLY

IN THE NAME OF  
**JULIA ANN WHEELER**

ORIGINAL WATER RIGHTS PERFECTED UNDER PERMITS U-487 AND G-2165

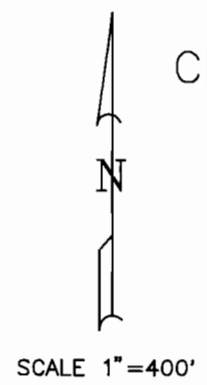

- AREA BEING IRRIGATED UNDER PIVOT WELL
- AREA BEING IRRIGATED UNDER HOUSE WELL

PIVOT WELL  
1337.4 FEET WEST AND 1337.5 FEET SOUTH OF THE NORTHEAST CORNER OF SECTION 27.

CORNER AREAS NOT UNDER PIVOT ARE BEING IRRIGATED WITH HAND LINE SPRINKLERS  
3 INCH HAND LINE CAN ATTACH TO END OF PIVOT  
SEE ATTACHED SITE REPORT FOR FURTHER INFORMATION



REVISIONS	BY
8/30/95	DJA

ANDERSON ENGINEERING & SURVEYING  
 HC 64 BOX 24-RWY. 396  
 P.O. BOX 28  
 LAKEVIEW, OREGON 97630  
 (503) 947-4407  
 FAX 947-2321

PREPARED FOR: JULIA ANN WHEELER  
 P.O. BOX 434  
 CHRISTMAS VALLEY, OR 97641

DATE: JULY 1995
SCALE: 1" = 400'
DWG. BY: DJA
JOB # 95062
DWG. FILE: 95062
SHEET
1
OF 1 SHEETS

PREPARATION OF THIS MAP IS FOR WATER RIGHT CONSIDERATIONS ONLY AND DOES NOT INDICATE PROPERTY OR OWNERSHIP LINES