


T. 2 N., R. 30 E., W.M.

RECEIVED
AUG 27 1998
WATER RESOURCES DEPT
SALEM, OREGON

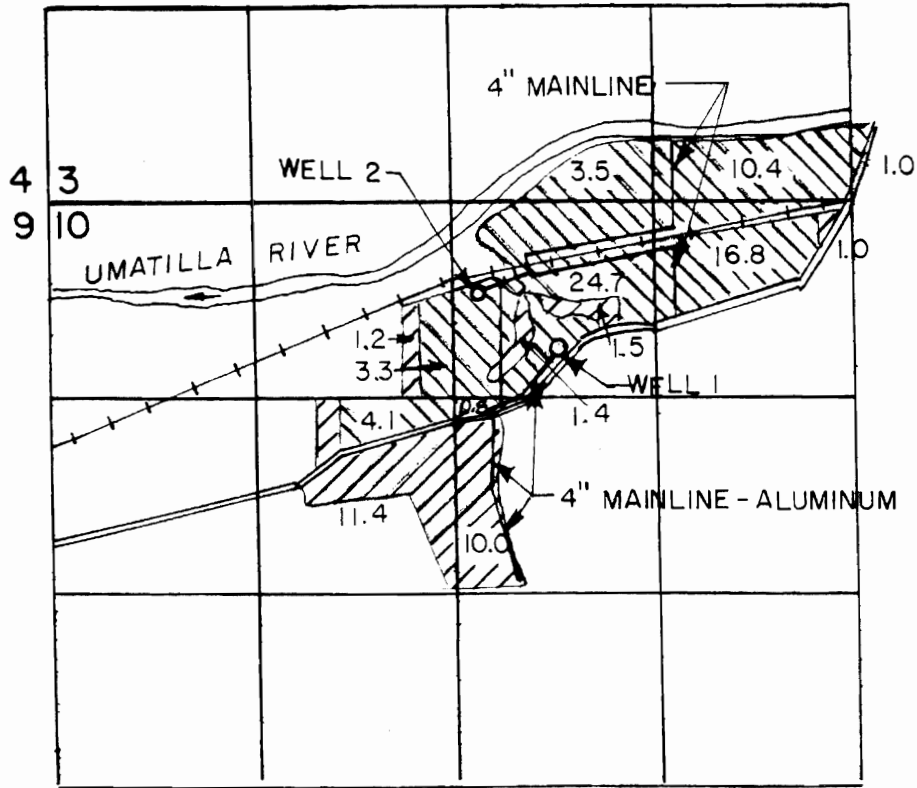

N
1" = 1320'

 PRIMARY  SUPPLEMENTAL

WELL 1- LOCATED 975' S & 750' E FROM THE N 1/4 CORNER, SECTION 10.
WELL 2- LOCATED 2050' N & 250' E FROM THE CENTER, SECTION 10.

FINAL PROOF SURVEY UNDER

Application No. G-6441 Transfer No. 6845
IN NAME OF

THEODORE A. HENDRICKSON

THIS MAP IS FOR IDENTIFYING THE LOCATION OF WATER RIGHTS ONLY, AND HAS NO INTENT TO PROVIDE DIMENSIONS OR LOCATIONS OF PROPERTY OWNERSHIP LINES.

Certified Water Right Examiner
184
William N. Reynolds
William N. Reynolds
May 17, 1998
STATE OF OREGON