


T. 4 S., R. 1 E., W.M.

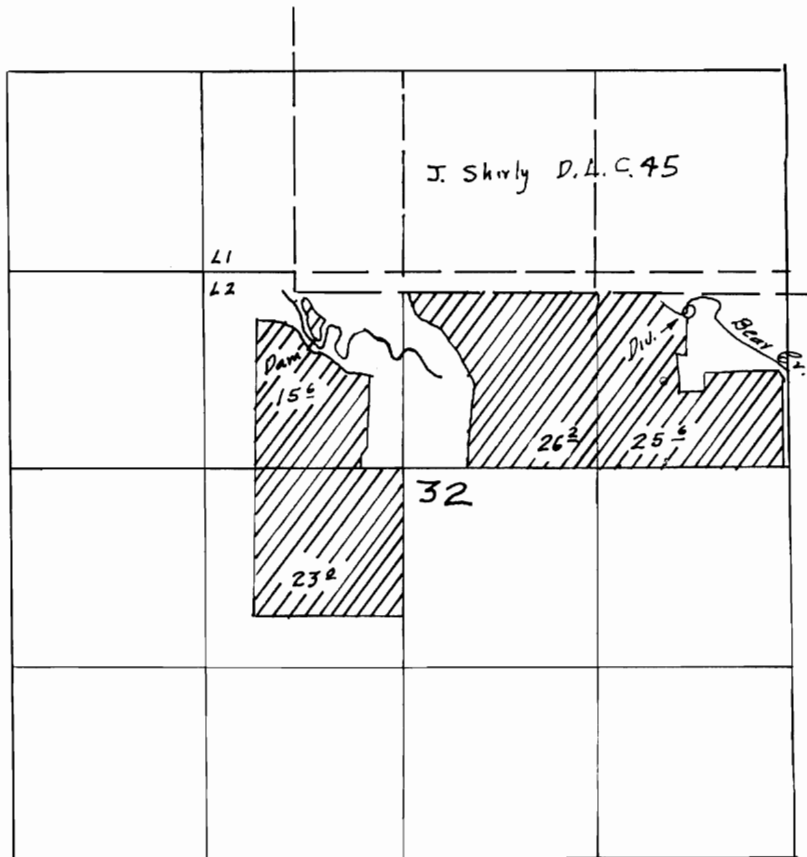

FINAL PROOF SURVEY  
UNDER

App. No 21449 Permit No. 16827  
IN NAME OF

I. R. Hanson

Surveyed July 8 1953 by H. L. Coffman

DFK-30-22