
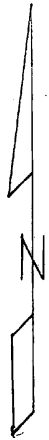


TOWNSHIP 14 SOUTH, RANGE 5 WEST, W.M.

RECEIVED

OCT 1 8 1998

WATER RESOURCES DEPT.
SALEM, OREGON

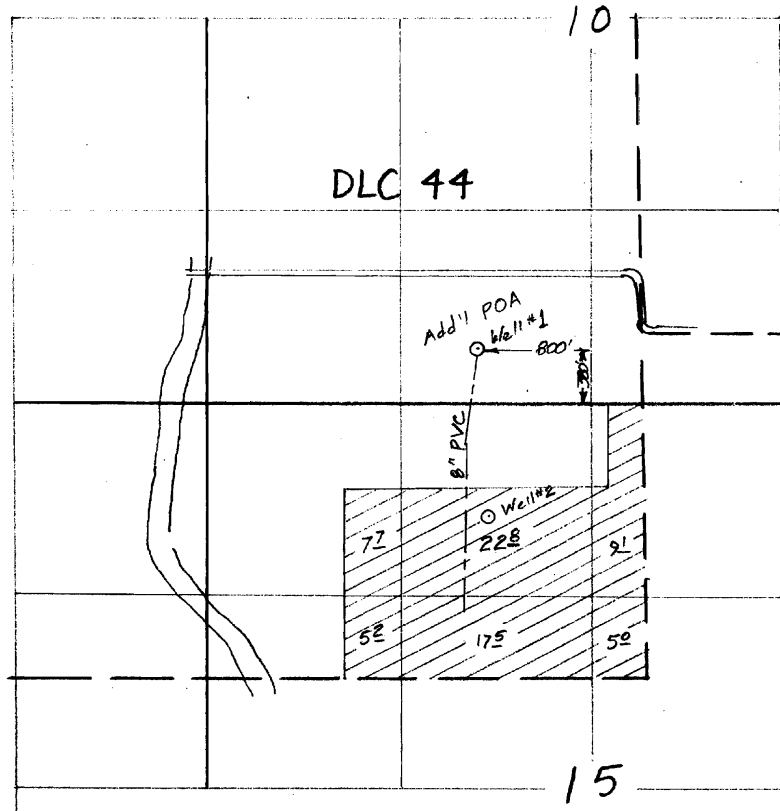


Scale 1" = 1320'

Surveyed September 22, 1997

Claim of Beneficial Use Map
for
CROCKER FARMS

T-6880

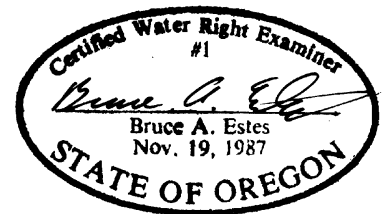

This map is for the purpose of locating a water right only and has no intent to provide legal dimensions or the location of property lines.

ESTES SURVEYS

6293 Sunnyview Rd. NE 60882 Arnold Rd.
Salem, OR 97305 Bend, OR 97702
(503) 585-7593 (503) 382-7391