



# Township 6 South, Ranges 1 East & 1 West, W. M.

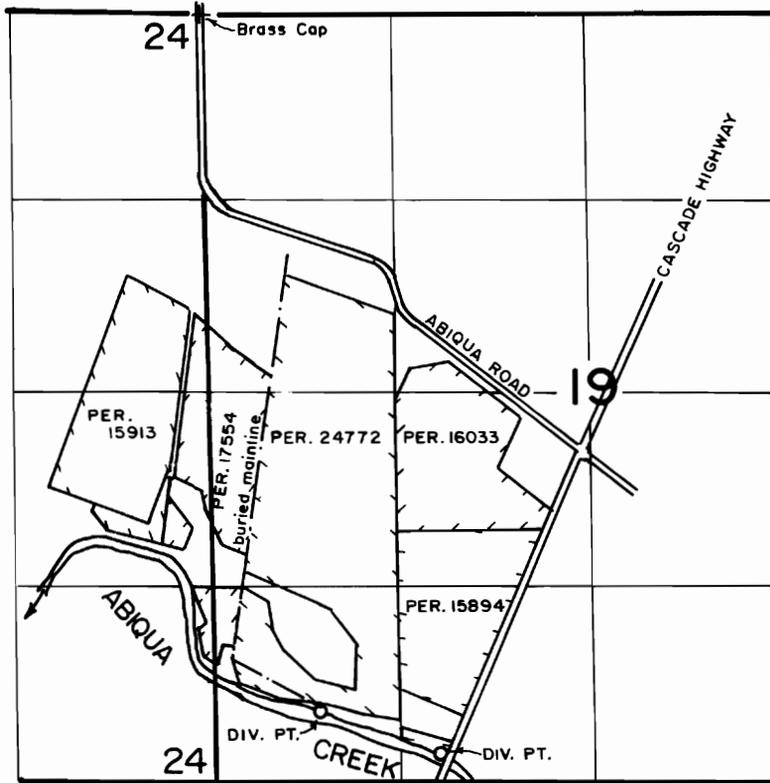

DIV. PTS. LOCATED: 4790' S. & 720' E., 5090' S. & 1570' E., BOTH FROM NW COR. SEC. 19.

FINAL PROOF SURVEY  
 under  
 Transfer 6895  
 in name of  
**GOSCHIE FARMS, INC.**  
 April 2, 1999

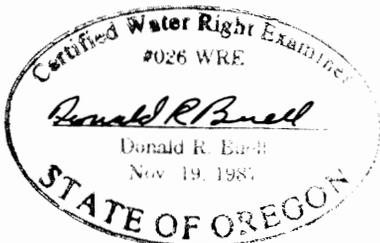

THIS MAP WAS PREPARED FOR THE PURPOSE OF IDENTIFYING THE LOCATION OF A WATER RIGHT ONLY AND IS NOT INTENDED TO PROVIDE LEGAL DIMENSIONS OR LOCATION OF PROPERTY OWNERSHIP LINES.