


T. 7S., R. 38E., W.M.

THE PURPOSE OF THIS MAP IS FOR IDENTIFYING THE LOCATION OF THE WATER RIGHT ONLY AND IS NOT INTENDED TO PROVIDE LEGAL DIMENSIONS OF PROPERTY OWNERSHIP LINES.

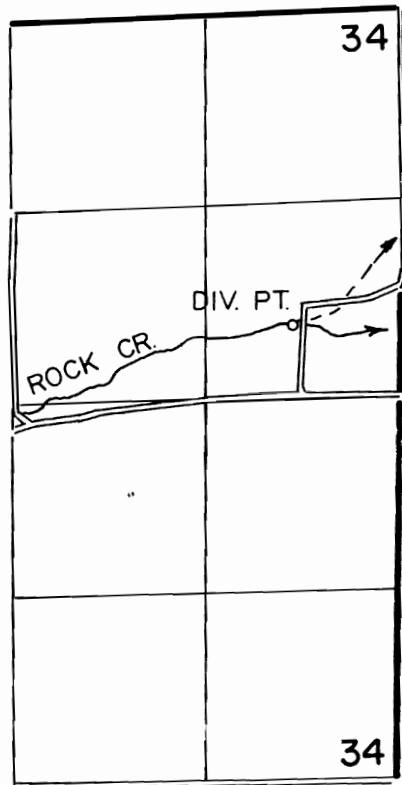


SCALE 1" = 1320'

DIV. PT. - 500'N. & 730'W. from E1/4 corner, Sec. 34



FINAL PROOF SURVEY
for
HELEN FISHER-T6900

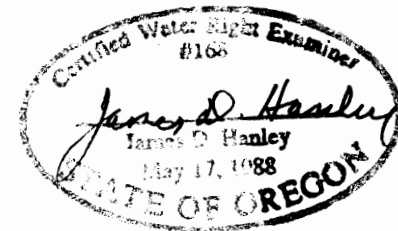

HANLEY ENGINEERING
2043 MAIN STREET
BAKER CITY, OREGON