



TOWNSHIP 6 SOUTH, RANGE 1 EAST, W.M.

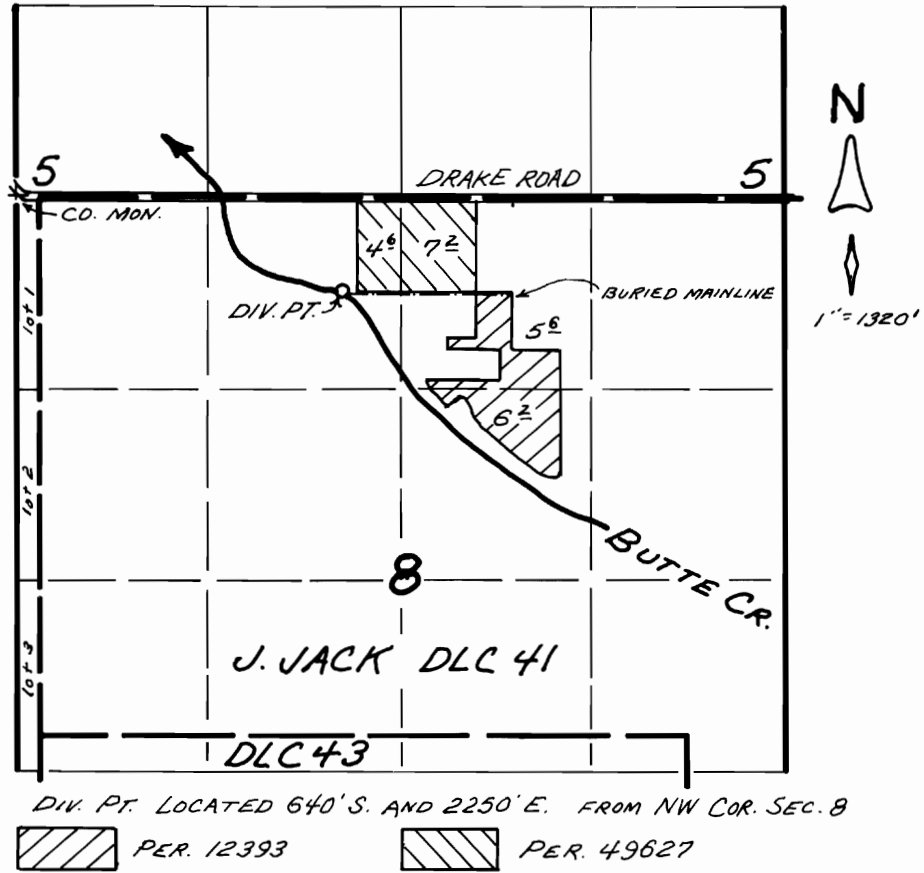

FINAL PROOF SURVEY
 UNDER
 TRANSFER 6920
 IN NAME OF
 H.L. "CASEY AND MARJORIE E. JONES

Nov. 16, 1998

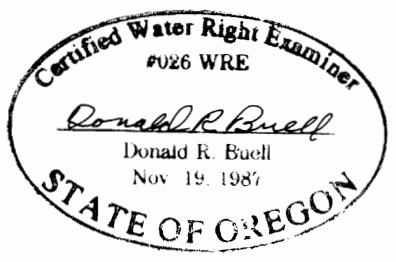

THIS MAP WAS PREPARED FOR THE PURPOSE OF IDENTIFYING THE LOCATION OF A WATER RIGHT ONLY AND IS NOT INTENDED TO PROVIDE LEGAL DIMENSIONS OR LOCATION OF PROPERTY OWNERSHIP LINES.