


RECEIVED

OCT 17 2011

WATER RESOURCES DEPT.
SALEM, OREGON

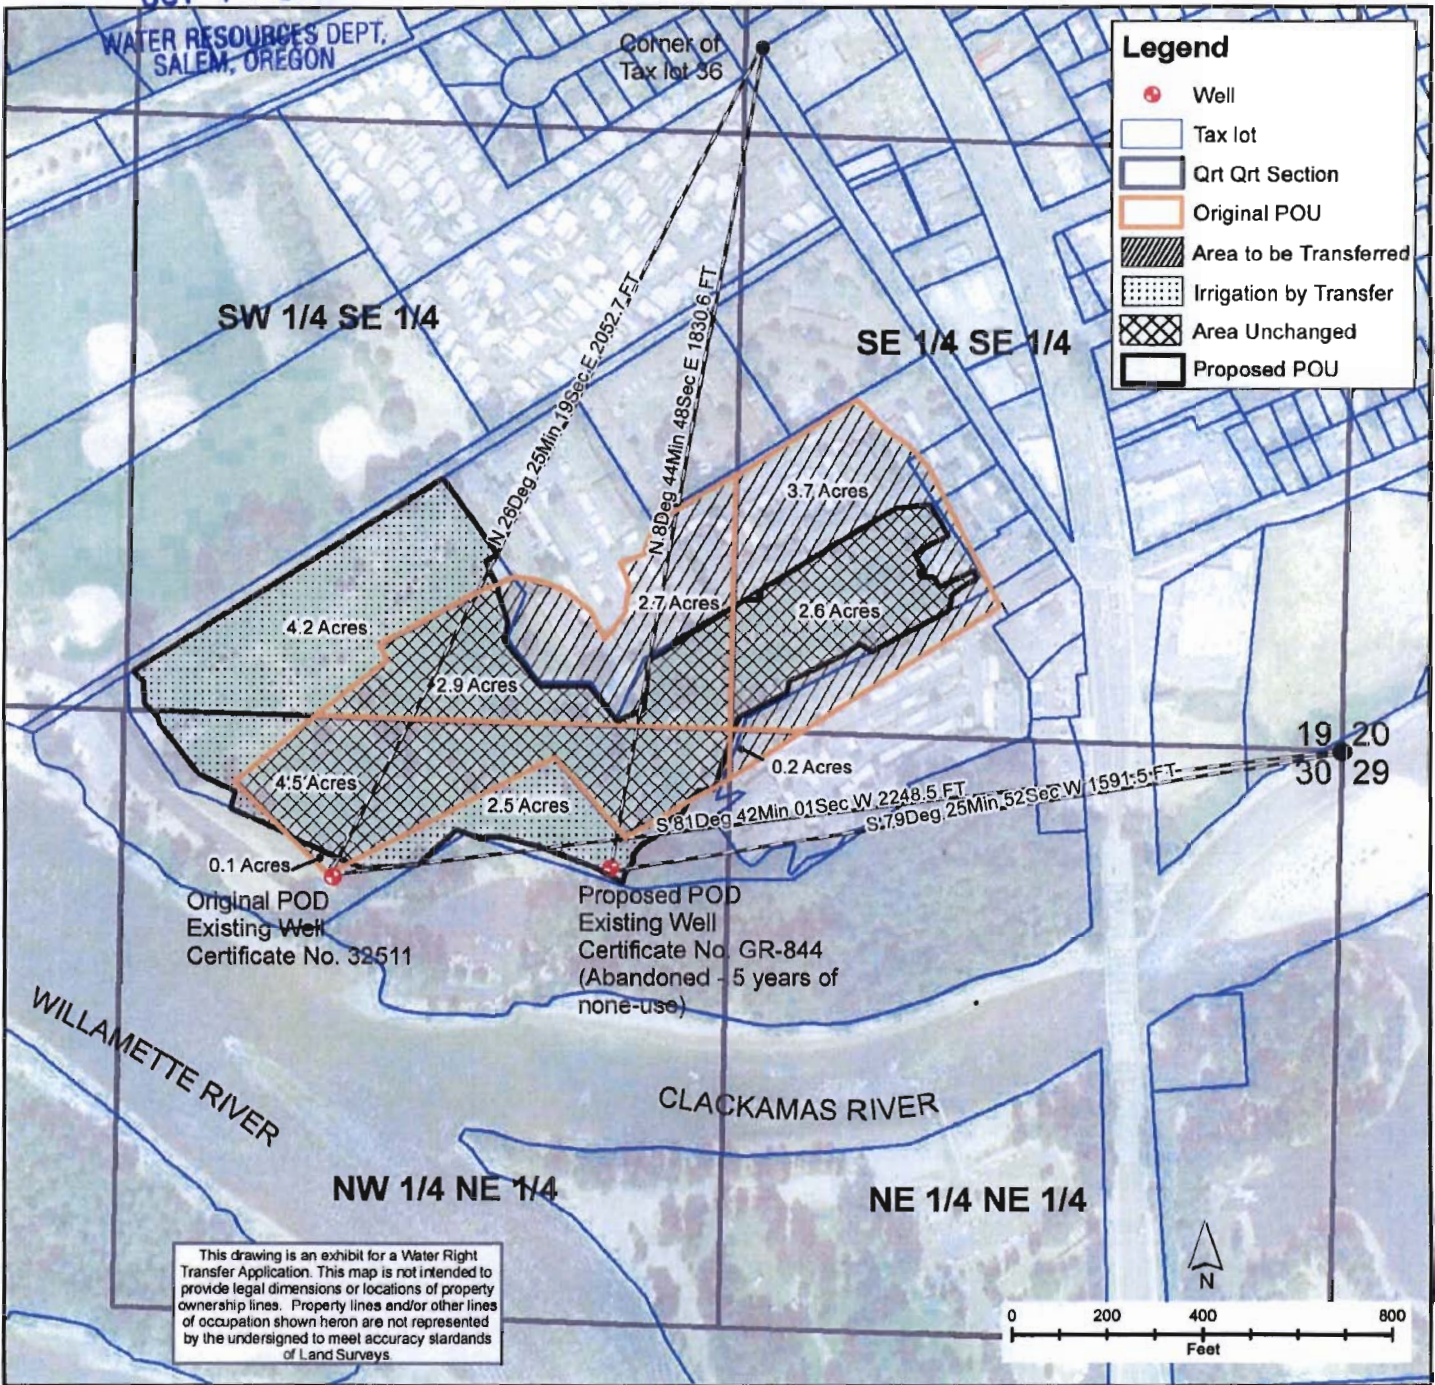

Certified Water Rights Examiner
#61438WRE
Jason K. Smiesrud
Jason K. Smiesrud
July 12, 2005
STATE OF OREGON

SECTIONS 19 & 30 T.2S. R.2E. W.M.
CLACKAMAS COUNTY, OREGON

TRANSFER No. 6942

EXPIRATION DATE: 6/30/2010




2020 SW 4th Ave
Portland, Oregon
97201

THE CHILDREN'S COURSE
IRRIGATION WATER RIGHT POU & POD
TRANSFER MAP

A discrepancy was discovered between the actual POU within the SE 1/4 SE 1/4 of Section 19 and the POU described in Certificate 32511 and mapped on the final proof survey map dated August 11, 1964. By reproducing the final proof survey map through digitization within GIS, it was determined that while the place of use footprint remains unchanged, the mapped POU is actually only 6.3 acres instead of the 7.8 acres labeled on the map and described within Certificate 32511. As part of this transfer application, the POU in the SE 1/4 SE 1/4 of Section 19 should be redescribed to reduce the acreage by 1.5 acres. This will result in the water right described under Certificate 32511 being reduced from 18.2 acres to 16.7 acres and from 0.23 cubic feet second to 0.21 cubic feet per second (94.3 gallons per minute).

Legend

- Well
- Tax lot
- Qrt Qrt Section
- Original POU

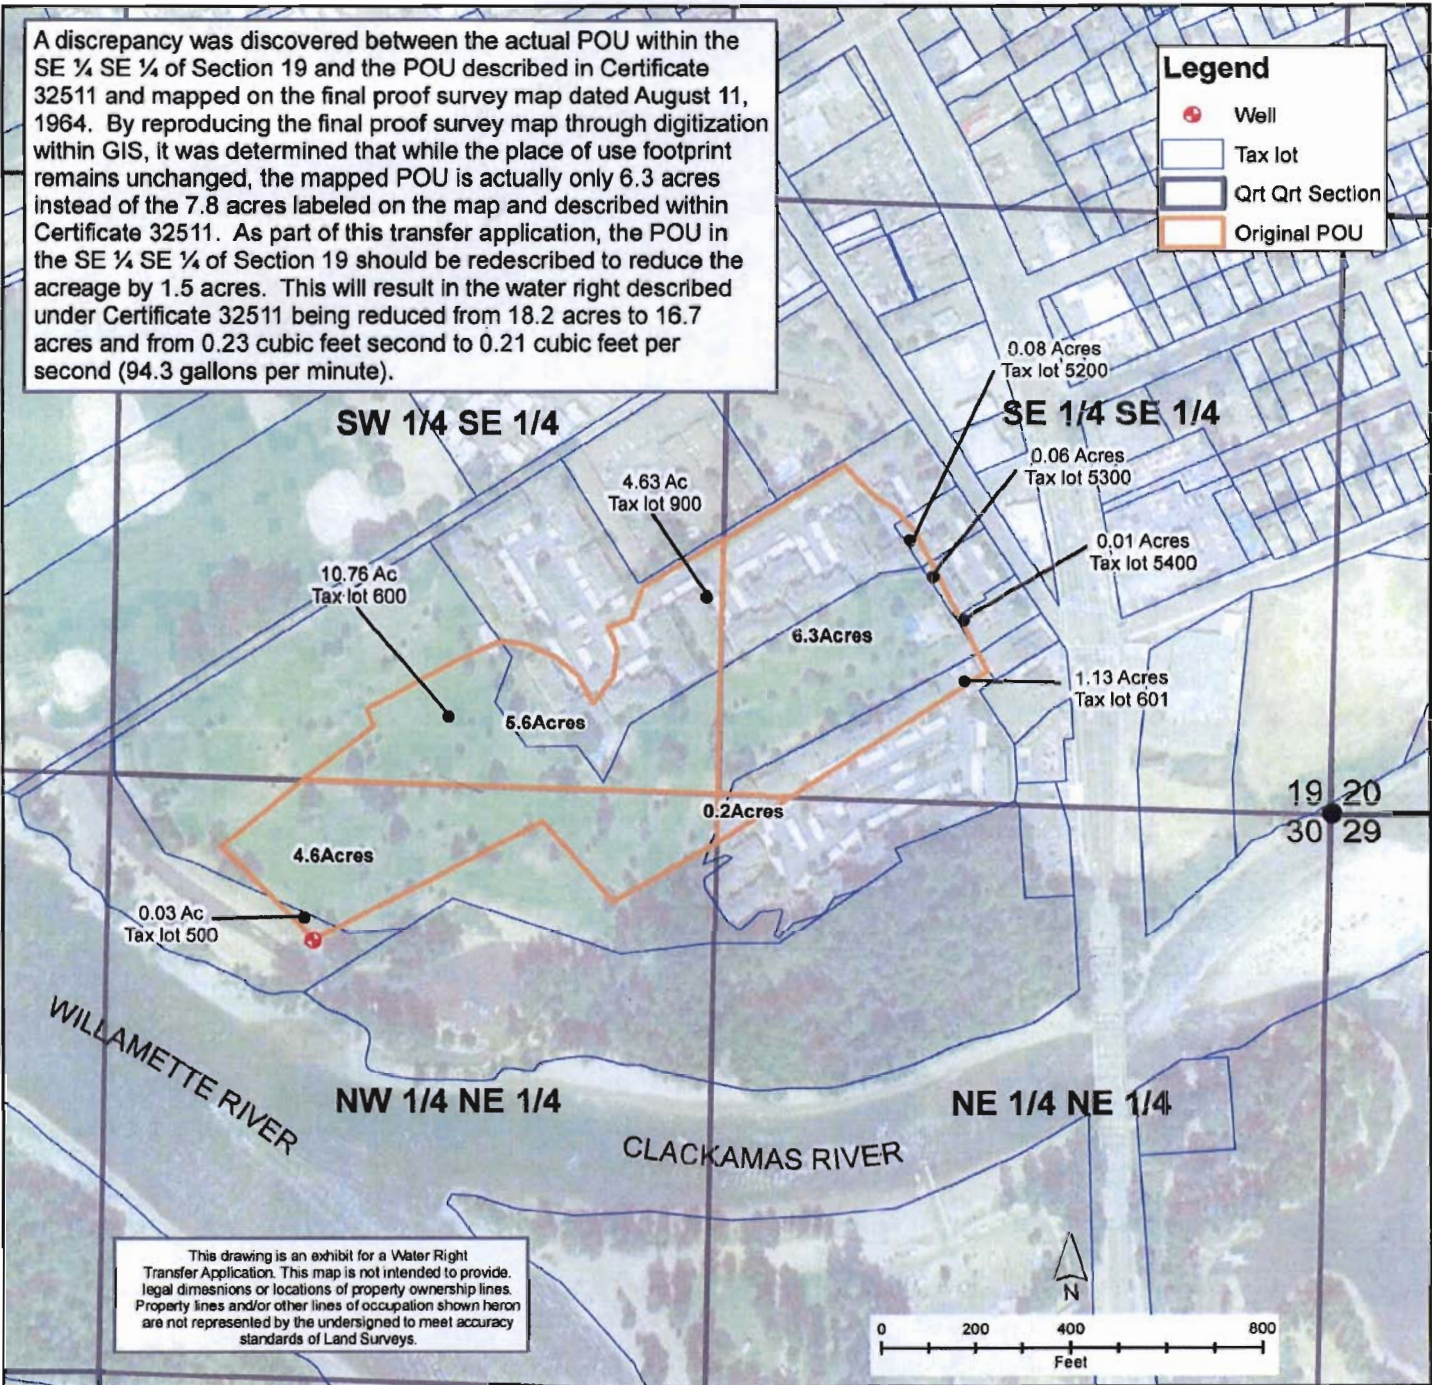

This drawing is an exhibit for a Water Right Transfer Application. This map is not intended to provide legal dimensions or locations of property ownership lines. Property lines and/or other lines of occupation shown hereon are not represented by the undersigned to meet accuracy standards of Land Surveys.

Certified Water Rights Examiner
 #61438WRE
Jason K. Singsrud
 Jason K. Singsrud
 July 12, 2005
STATE OF OREGON

SECTIONS 19 & 30 T.2S. R.2E. W.M
 CLACKAMAS COUNTY, OREGON

RECEIVED
 OCT 17 2011

TRANSFER No. 6942

EXPIRATION DATE: 6/30/2010

WATER RESOURCES DEPT.
 SALEM, OREGON

CH2MHILL

2020 SW 4th Ave
 Portland, Oregon
 97201

THE CHILDREN'S COURSE
 CERTIFICATE 32511 FINAL PROOF
 SURVEY MAP REPRODUCTION