

T. 4 N., R. 27 E., W.M.


RECEIVED

SEP - 3 1991

WATER RESOURCES DEPT.
SALEM, OREGON




SCALE 1" = 1320'

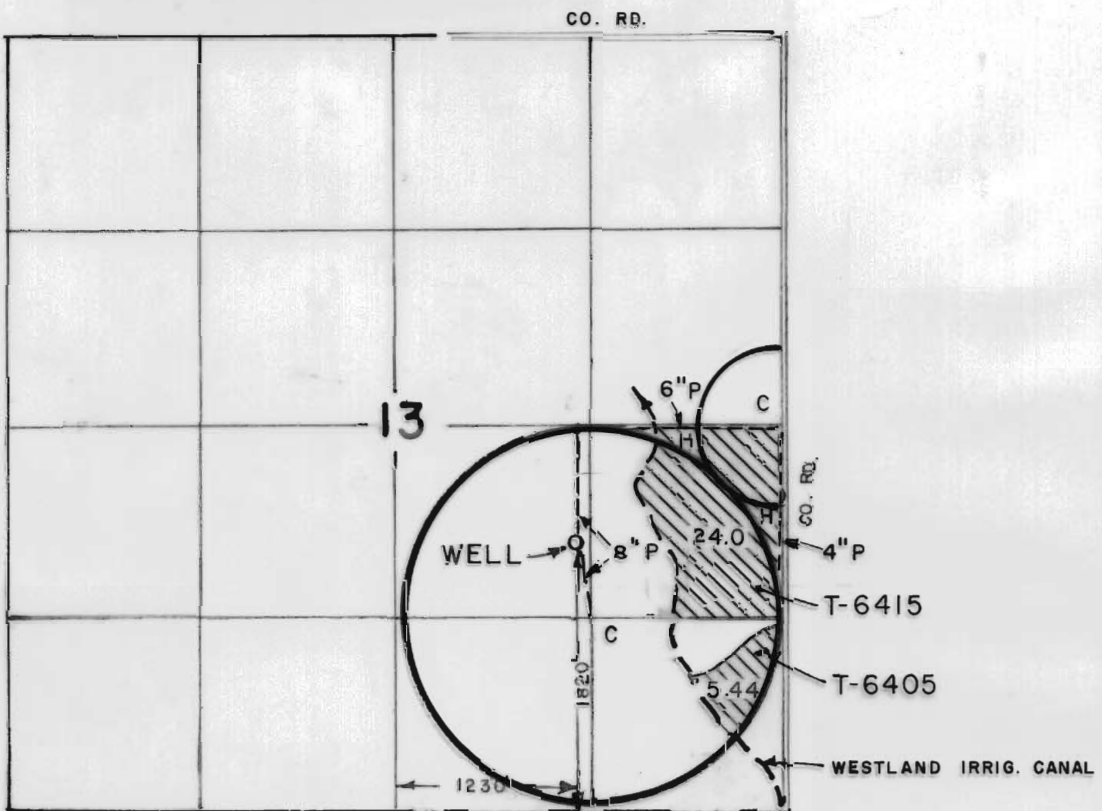

POINT OF DIVERSION LOC. 1820' N & 1230' E FROM S 1/4 COR.
SEC. 13, T. 4 N., R. 27 E., W.M.

The preparation of this map was for the purpose of identifying the location of water right only, and has no intent to provide dimensions or location of property ownership lines.

- C = CENTER PIVOT
- P = BURIED PIPELINE
- H = HANDLINES

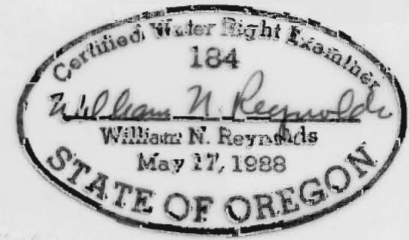

FINAL PROOF SURVEY

UNDER

Application No. **T-6405** Permit No. **G-2620, G-4039**
T-6415 **G-3966**

IN NAME OF

MALCOLM SKINNER

Surveyed July 11, 1991, by W.N. Reynolds