


T. 5N., R. 28E., W.M.

UMATILLA COUNTY

SCALE 1" = 1320'

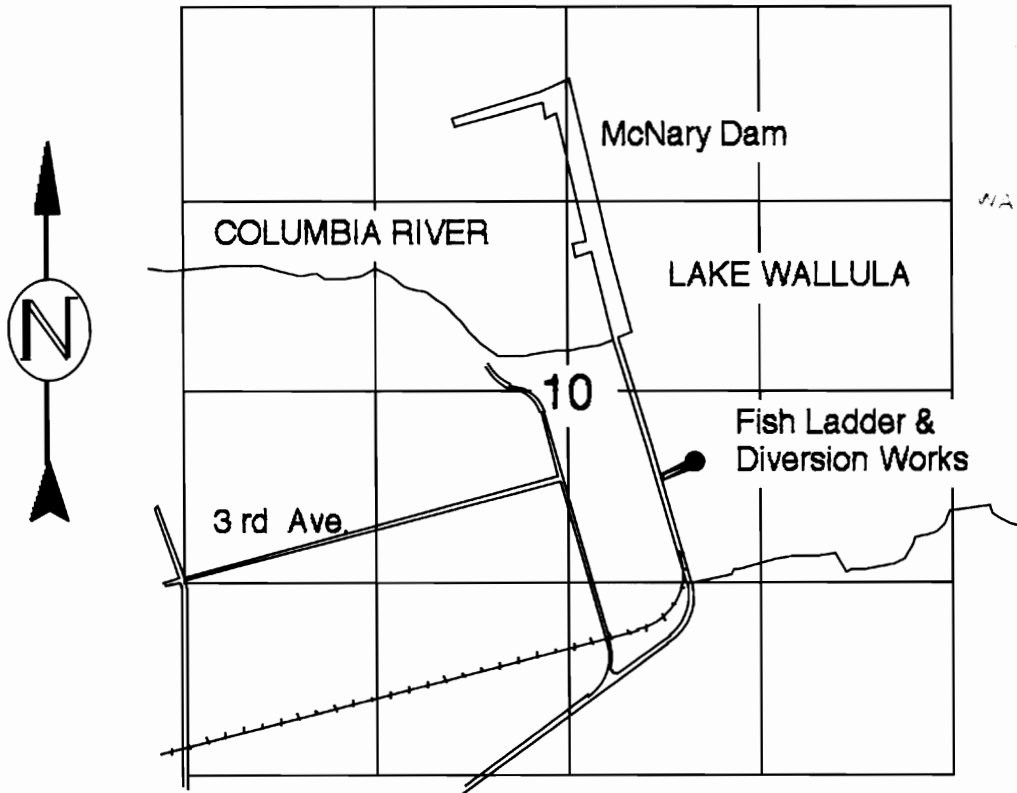

RECEIVED
MAR 28 1996

WATER RESOURCES DEPT
SALEM, OREGON

P.O.D. Located 2150 Ft. North & 3500 Ft. East of the Southwest Corner of Section 10

WATER RIGHTS PROOF MAP

West Extension Irrigation District - Additional Point of Diversion

IN NAME OF

West Extension Irrigation District

TRANSFER# T-6959
PERMIT #33883

THIS MAP IS FOR THE PURPOSE OF IDENTIFYING THE LOCATION OF WATER RIGHTS ONLY AND IS NOT INTENDED TO PROVIDE THE LEGAL DIMENSIONS OR LOCATIONS OF PROPERTY OWNERSHIP LINES.

Water Right Examine
#002 WRS
RONALD V. McKINNIS
NOV. 29, 1988
STATE OF OREGON
EXP. 12-31-96

ENGINEERING - SURVEYING - WATER RIGHTS
R V McKINNIS ENGINEERING
Rt 1 Box 1122 Hermiston, Oregon 97838
503-567-2017