

T. 15 S., R. 3 W. W.M.

RECEIVED

SECTION 32

FINAL PROOF SURVEY

WATER RESOURCES DEPT.  
SALEM, OREGON

UNDER

TRANSFER FILE T- 7127

IN NAME OF  
DAVID MALPASS  
MUDDY CREEKS IRRIGATION PROJECT

PRIORITY: 1.) FEBRUARY 9, 1939  
DATE 2.) MARCH 1, 1978

3.) AUGUST 13, 1986

29

28

30 29

31 32

32 33

POINT OF DIVERSION MUDDY  
CREEK, 1350 FEET NORTH &  
490 FEET WEST FROM THE SE COR.  
GREENWOOD DLC NO. 64,  
SEC. 30, T. 15 S.R. 3 W. W.M.

T. 15 S. 31

32

33

T. 16 S. 6

5

4

B.P. GREENWOOD DLC 64

32

DIV. PT. 1

DIV. PT. 2

MUDDY CREEK

1000'

35.8

27.2

0.1

MAIL LINE

15.0

34.9

38.4

DITCH

32


COUNTRY ROAD #523



SCALE

1" = 1320'

JULY 22, 1998

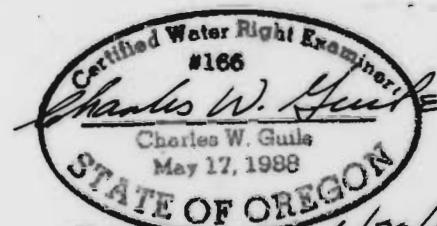

LOCAL:

DIV. PT. 1. 870' N. & 2660' W. FROM  
SE COR. SEC. 32.

DIV. PT. 2. 830' N. & 2625' W. FROM  
SE COR. SEC. 32.

POINT OF DIVERSION MCKELZIE RIVER  
4440' FEET SOUTH AND 5250 FEET  
EAST FROM THE SE COR. MAHNSFIELD  
DLC 79, SEC. 9, T 17 S. R. 3 W. W.M.

THIS MAP IS FOR WATER RIGHT  
PURPOSES ONLY AND IS NOT  
INTENDED TO PROVIDE DIMENSIONS  
FOR LOCATING PROPERTY BOUNDARIES.  
SURVEYED MARCH 2, 1994

CHARLES W. GUILE  
& ASSOCIATES, CO.  
Land Surveying  
62 Centennial Loop  
Eugene, OR 97401

92-41G