


**FINAL PROOF SURVEY MAP**  
 IN THE NAME OF JAMES R. NICHOLS  
 TRANSFER 6982

PERMIT 19325                      CERTIFICATE 22667

SECTIONS 15 & 22, TOWNSHIP 25 SOUTH, RANGE 6 WEST, W.M.

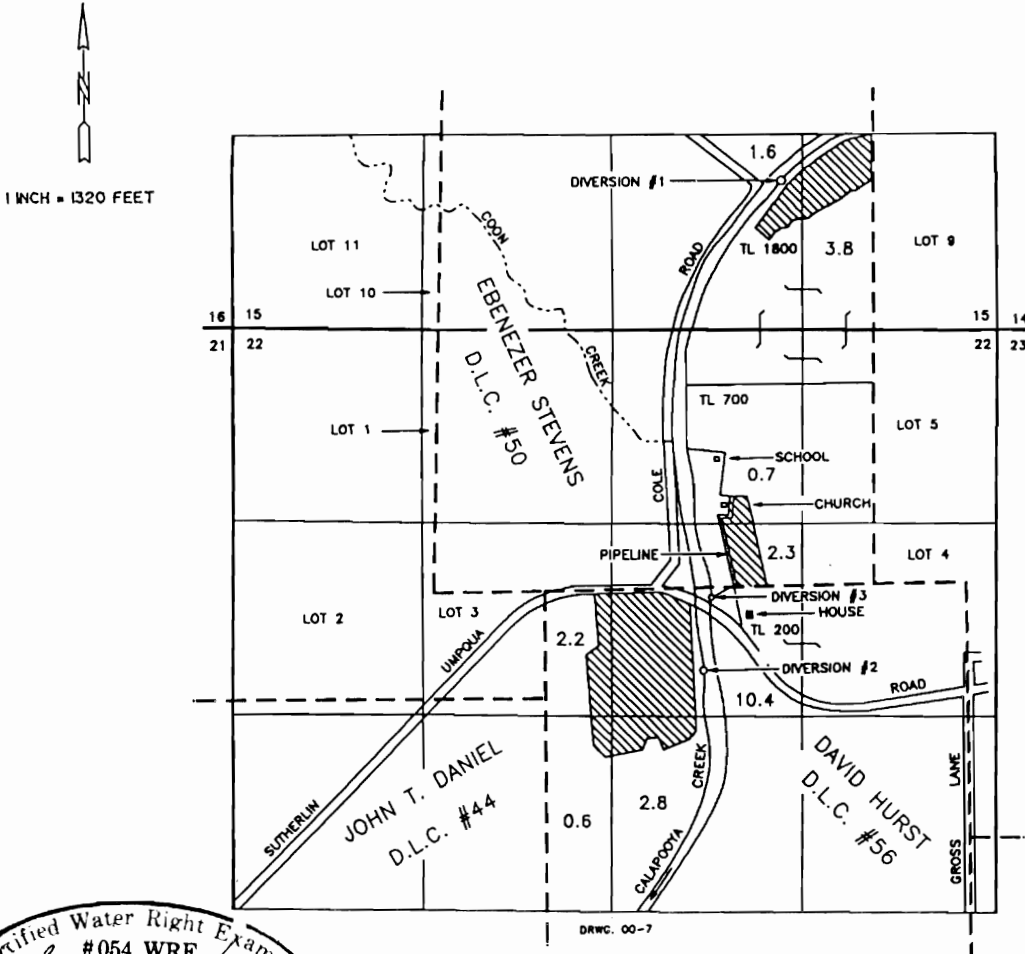

**RECEIVED**

MAY 15 2000

**WATER RESOURCES DEPT  
 SALEM, OREGON**

Certified Water Right Examiner  
 #054 WRE  
*James F. Gosson*  
 James F. Gosson  
 Nov. 19, 1987  
 STATE OF OREGON

Diversion #3 is located 840 feet north and 1900 feet west from the east 1/4 corner of Section 22, being within the SW 1/4 NE 1/4 Section 22, Township 25 South, Range 6 West, W.M., Douglas County, as projected within the David Hurst Donation Land Claim #56.

The purpose of this map is to identify the location of the water right. It is not intended to provide information relative to the location of property ownership boundary lines.