



TOWNSHIP 3 NORTH, RANGE 28 EAST, W.M.

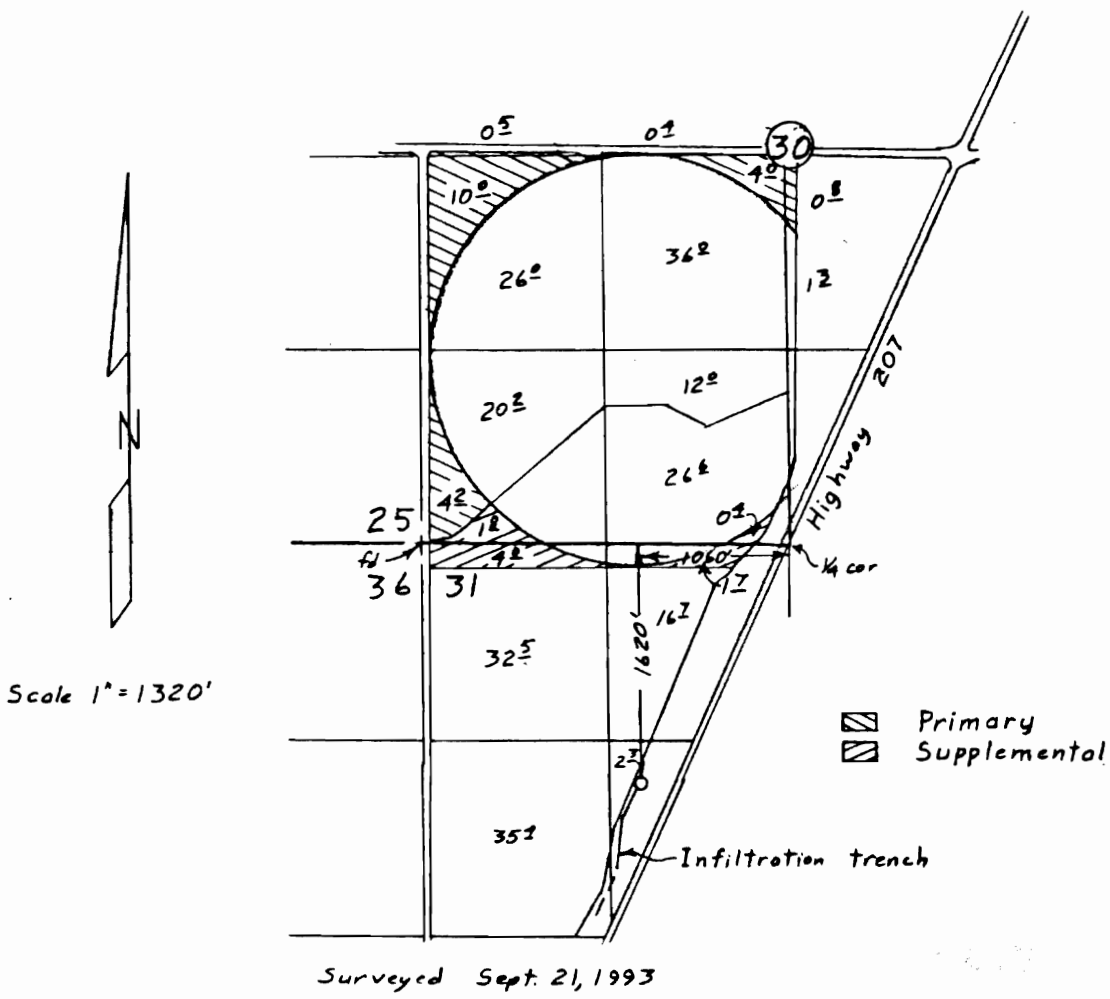

CLAIM OF BENEFICIAL USE MAP
TRANSFER T-6994
for
KENT & SHANNON MADISON

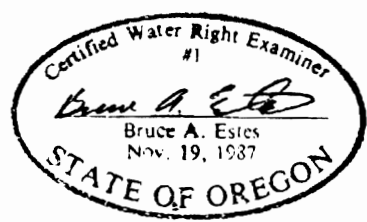

This map is for the purpose of locating a water right only and has no intent to provide the location of property lines or legal dimensions.