


T 2 S R 38 E

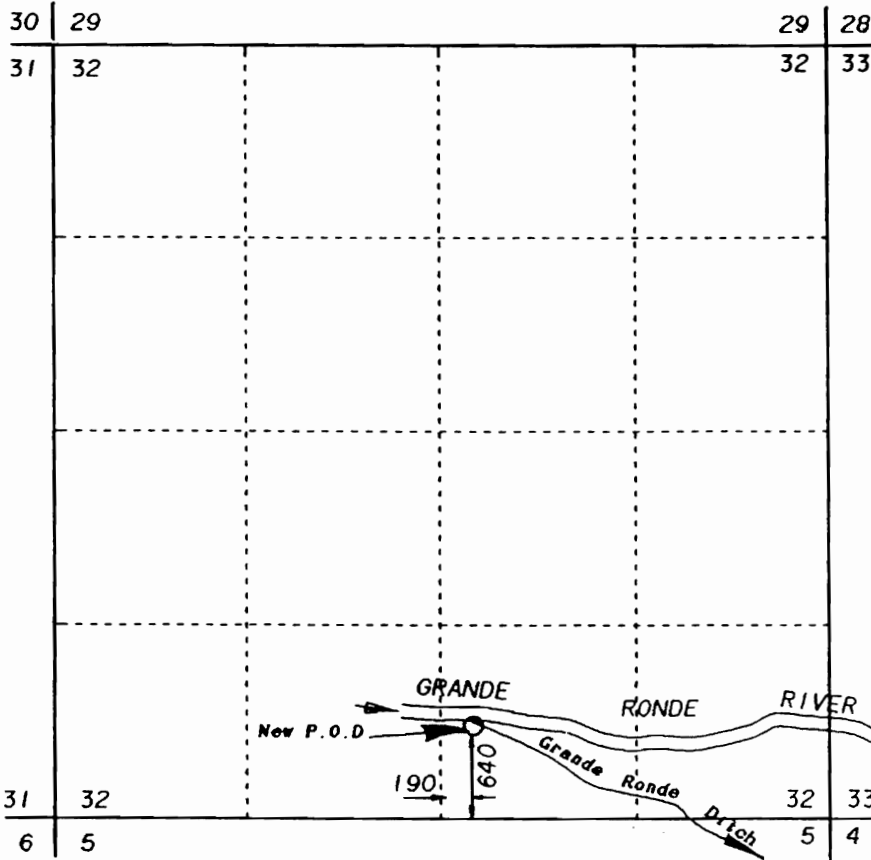


SCALE 1" = 1320'

RECEIVED

SEP 30 1997

WATER RESOURCES DEPT.
SALEM, OREGON

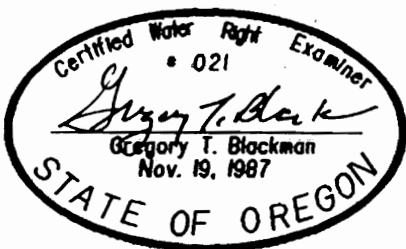

NOTE: The preparation of this map was for the purpose of identifying the location of the proposed water right and has no intent to provide dimensions or location of property ownership lines. Location information shown hereon was furnished by the applicant.

**FINAL PROOF MAP FOR
T-7150, T-7151, T-7152
CHANGE IN POINT OF DIVERSION
FOR
GRANDE RONDE VALLEY IMPROVEMENT
DITCH CO.**

BY
**BAGETT - GRIFFITH & BLACKMAN
2006 ADAMS AVENUE
LAGRANDE, OREGON 97850**

SEPTEMBER 18, 1997