

Sheet 1 of 1
FINAL PROOF SURVEY
Application T-7153
Certificate 13175

East Branch Little Walla Walla River -
Walla Walla River Irrigation District
diversion 1675' S. and 1112' E. of
N 1/4 Cor. Sec. 26.
concrete box in ditch - 5 HP pump

Ditch

T6N, R35E, W. M.,
SECTION 26



E 1/2

IP


Property Line



Scale: 1"=100'

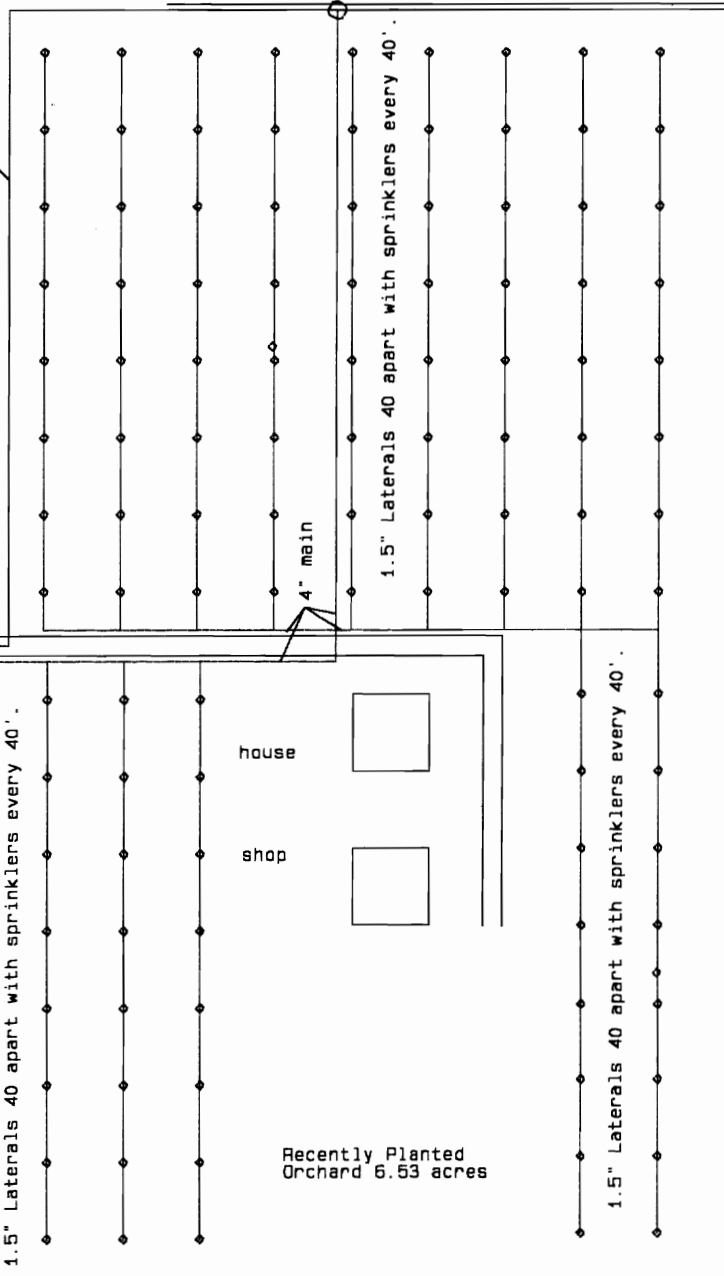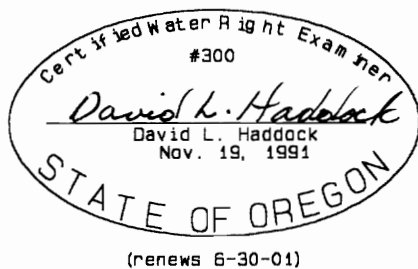

BC

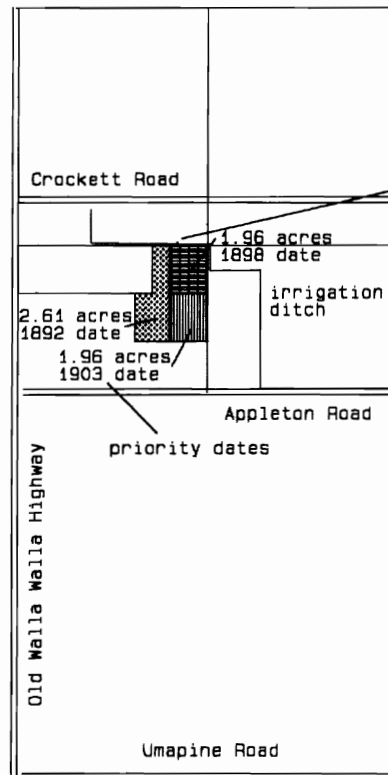

Scale: 1"=1320'

Little Walla Walla
River Irrigation
District Diversion
1675' S. & 1112'
E. of 1/4 Cor.
Sec. 23 & 26
6.53 acres
orchard irrigated

IP

BC

BC

NOTE:

The information shown
on this map is solely
for Water Rights
purposes. The data
shown does not represent
ownership information.

MONUMENTS SET

David L. Haddock, Surveyor and Engineer
P.O. Box 1574
Pendleton, Oregon 97801
(541) 276-2174

HADDOCK SURVEYING



GPS
AND
TOTAL STATION

Survey Date:

SURVEY FOR
Mr. Philip Davis
53486 Ruby Lane
Milton Freewater, OR 97862
541-938-7334