

T. 14 S. R. 4 W. W. M. SECTION 13 FINAL PROOF SURVEY UNDER

TRANSFER FILE T-7161

IN NAME OF
JOHN SCHUKIS

MUDDY CREEKS IRRIGATION PROJECT


PRIORITY DATE
FEBRUARY 9, 1939

SURVEYED APRIL 19, 2001



SCALE
1" = 1320'

LOCAL POINT OF DIVERSION
IS 1733.0 FEET SOUTH AND
60.0 FEET EAST OF WEST
1/4 COR. SEC. 13 T. 14 S. R. 4 W. W. M.

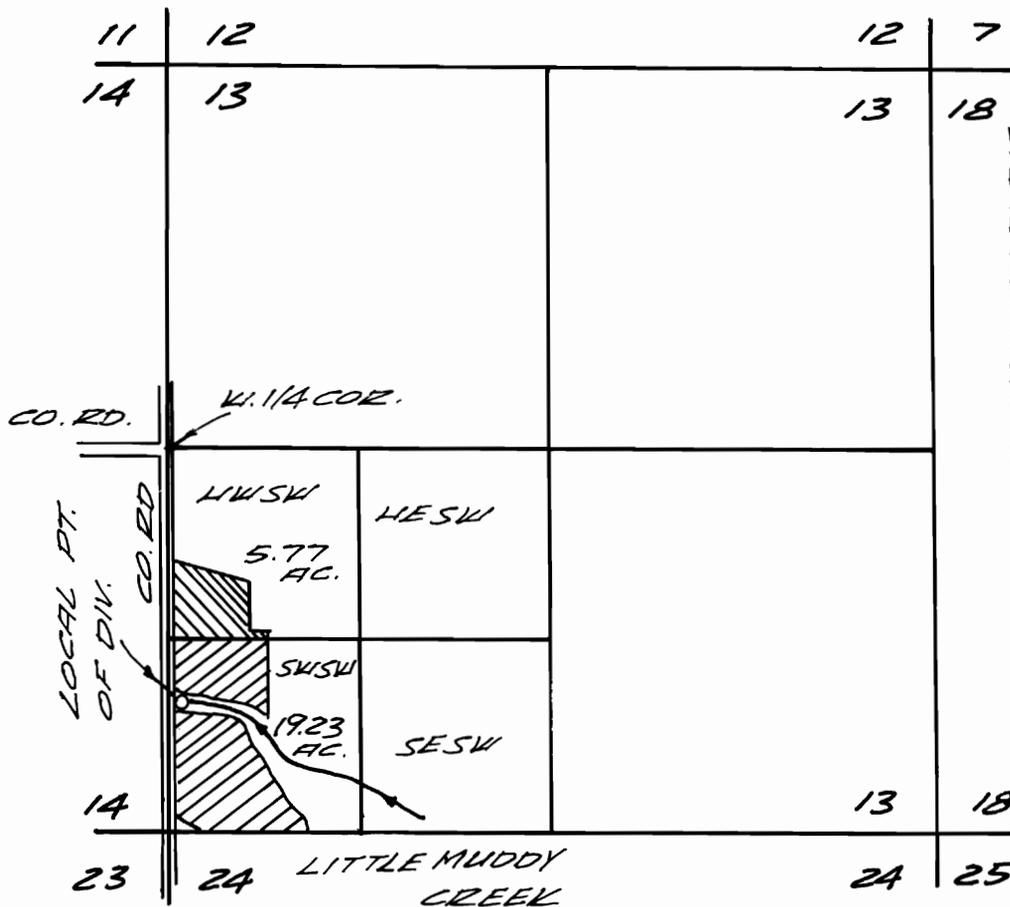

POINT OF DIVERSION, McKEENZIE
RIVER 4440 FEET SOUTH AND
5250 FEET EAST FROM THE SE
COR. MAHSFIELD DLC NO. 79
SEC. 9 T. 17 S. R. 3 W. W. M.
LITTLE MUDDY CREEK, SE 1/4
SEC. 14 T. 14 S. R. 4 W. W. M.

THIS MAP IS FOR WATER RIGHT
PURPOSES ONLY AND IS NOT
INTENDED TO PROVIDE DIMENSIONS
FOR LOCATING PROPERTY
BOUNDARIES.



6/30/2001

CHARLES W. GUILÉ
& ASSOCIATES, CO.
Land Surveying
52 Centennial Loop
Eugene, OR 97401

6/4/2001

92-41H