


T 39 S, R 3 W, W.M.  
 Section 13  
 Jackson County, Oregon

**RECEIVED**

FEB - 2 1998

WATER RESOURCES DEPT.  
 SALEM, OREGON

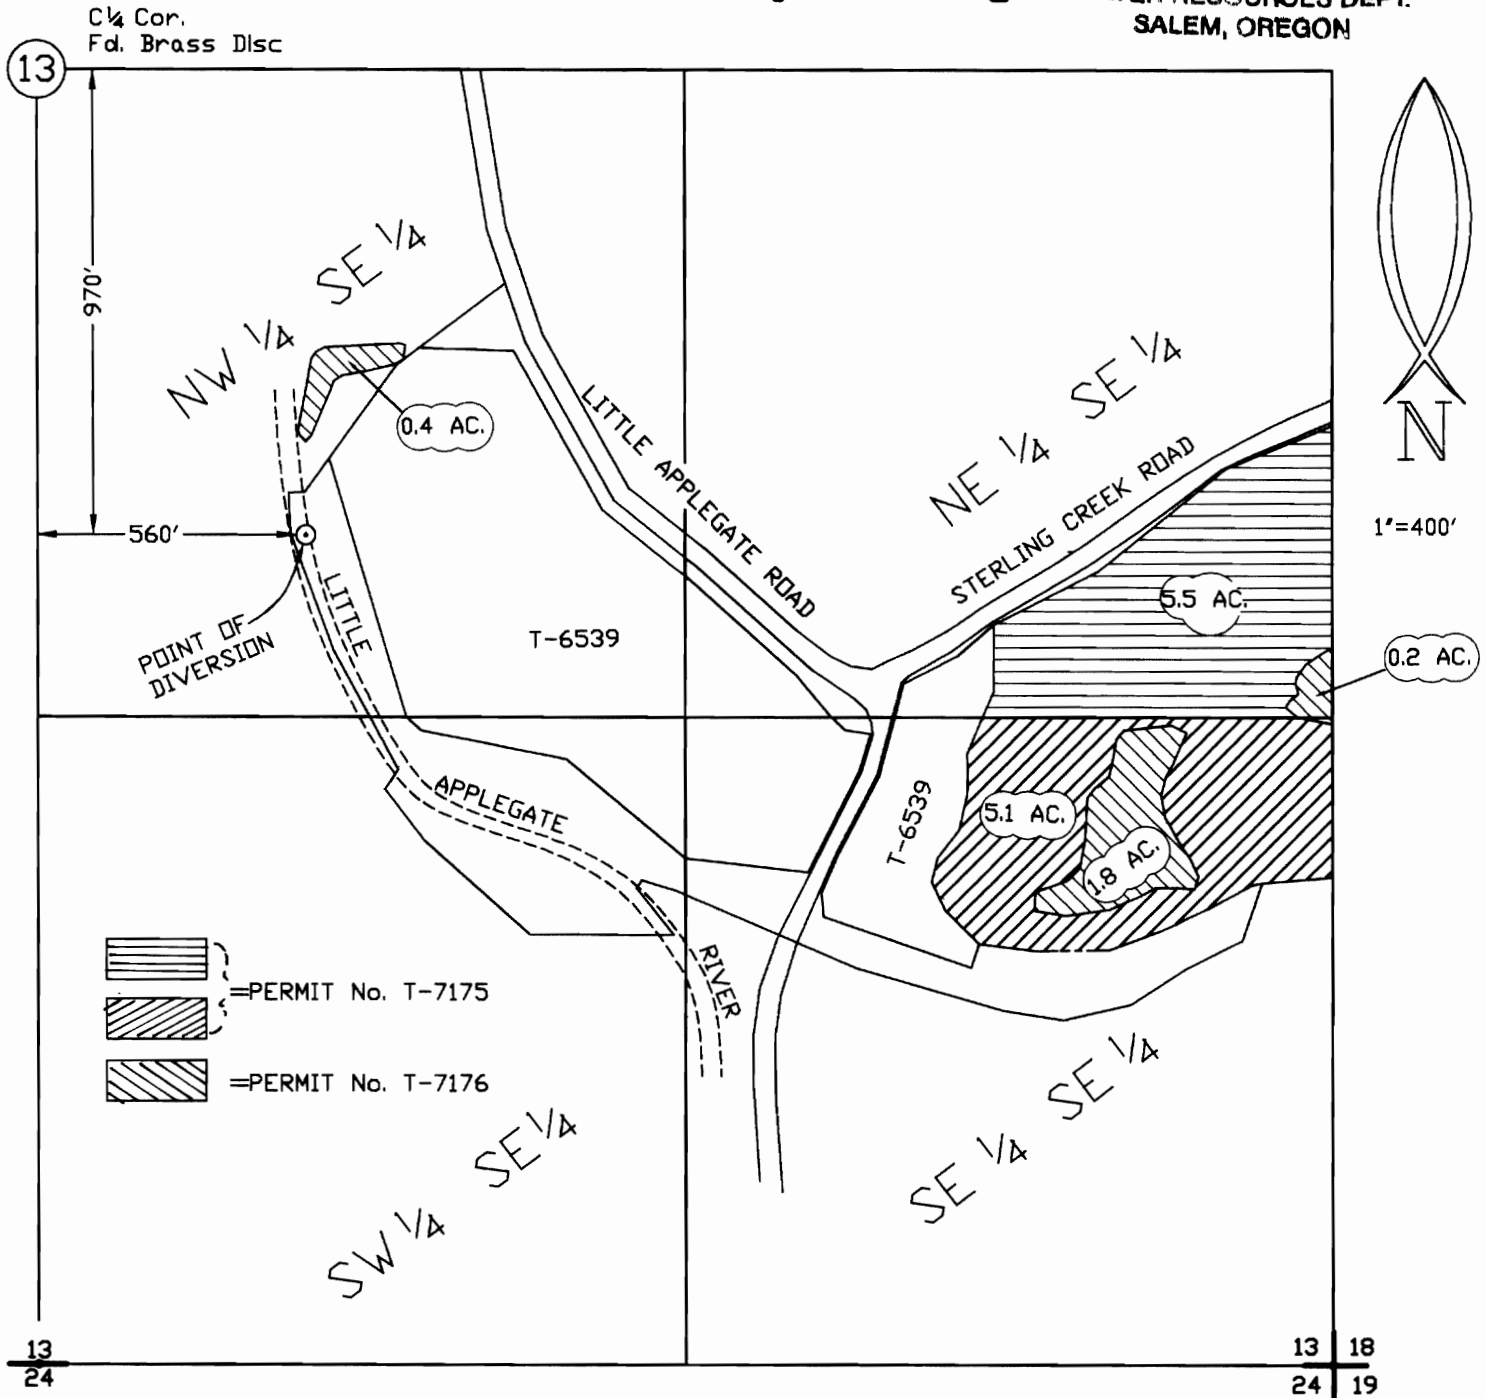


**FINAL PROOF SURVEY**

UNDER

CHANGE IN POINT OF DIVERSION

Application No. T-7175 & T-7176

IN THE NAME OF  
 REEVE L. HENNION

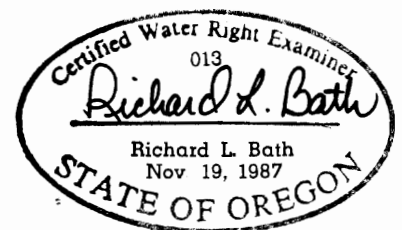

Surveyed SEPT. 12, 1997

By Richard L. Bath

Richard L. Bath  
 CWRE No. 013