

RECEIVED

SEP 27 2000

WATER RESOURCES DEPT
SALEM, OREGON


FINAL PROOF SURVEY

TRANSFER T-7182

JAMES R. STEWART
HC 60 BOX 1800
LAKEVIEW, OREGON 97630
(541) 947-2722

NE1/4 SECTION 32, TOWNSHIP 39 SOUTH, RANGE 19 EAST, W.M.

29 | 28
32 | 33

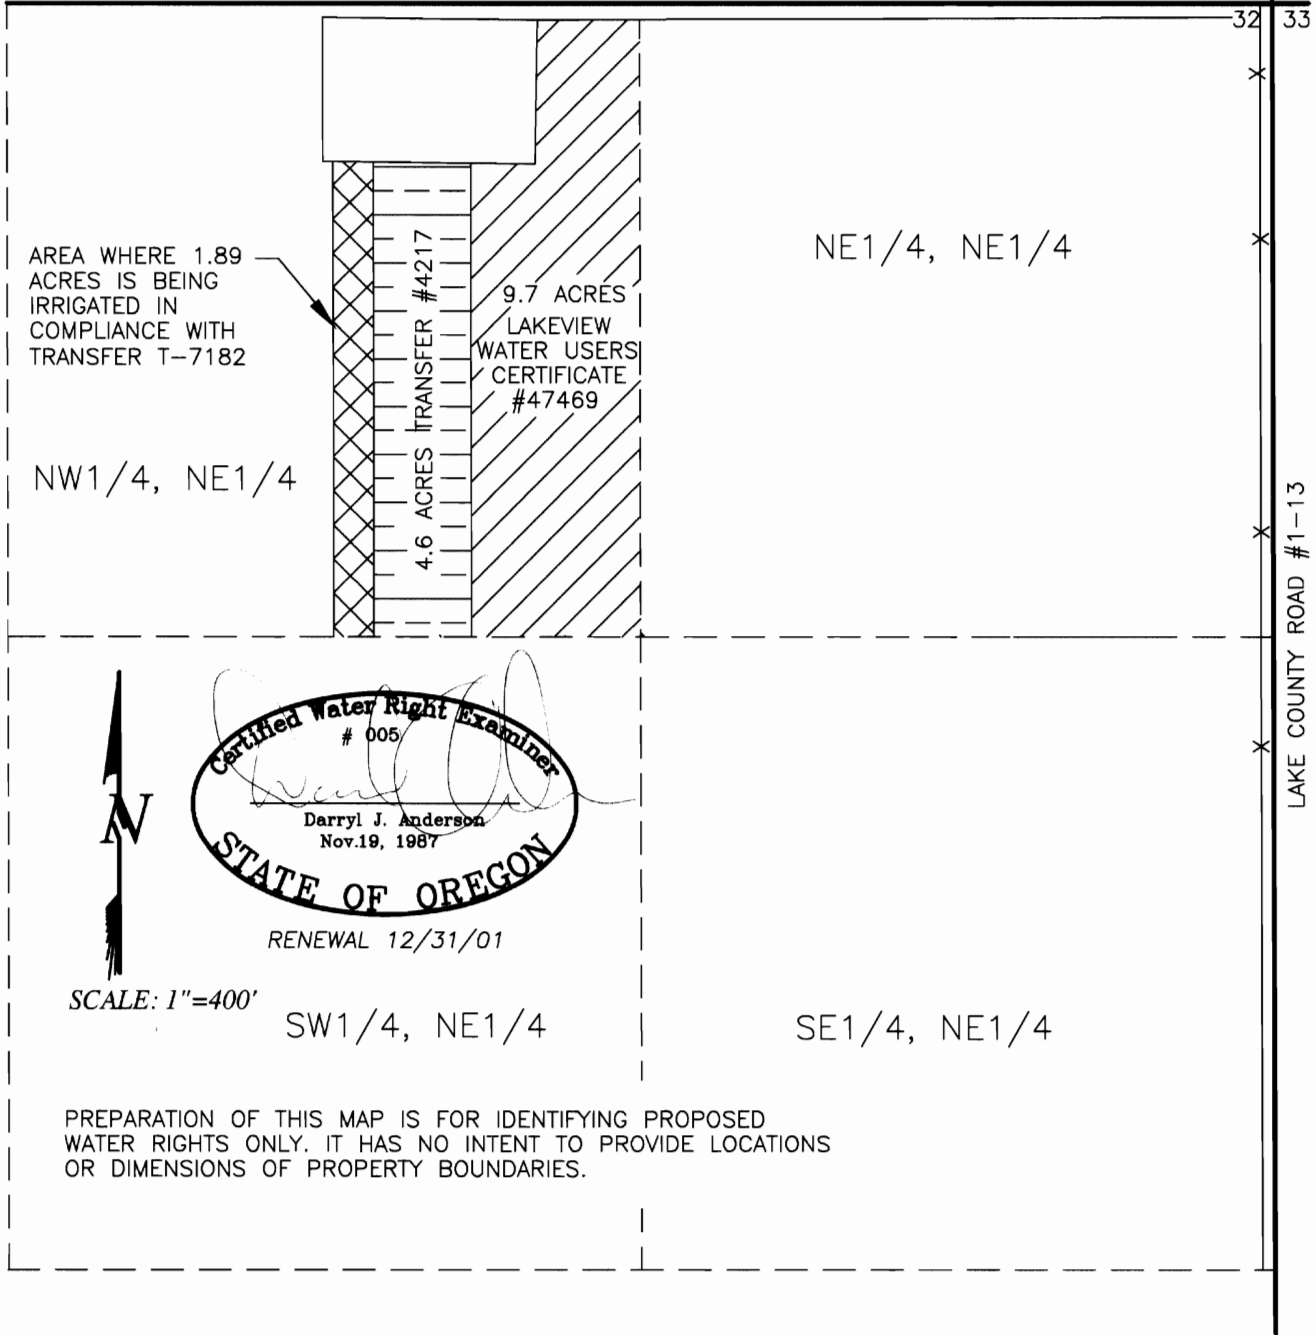

PREPARATION OF THIS MAP IS FOR IDENTIFYING PROPOSED WATER RIGHTS ONLY. IT HAS NO INTENT TO PROVIDE LOCATIONS OR DIMENSIONS OF PROPERTY BOUNDARIES.

DATE: 9/18/2000
SCALE: 1"=400'
JOB: 94025
DWG. BY: M.J.B.
FILE: 94025FP
SHEET 1 OF 1

JAMES R. STEWART
HC 60 BOX 1800
LAKEVIEW, OREGON 97630
(541) 947-2722

**ANDERSON ENGINEERING
AND SURVEYING, INC.**

P.O. BOX 28 LAKEVIEW, OREGON 97630 (541) 947-4407 FAX 947-2321	P.O. BOX 419 REDMOND, OREGON 97756 (541) 923-4307 FAX 923-4308
---	---