



TOWNSHIP 5 SOUTH, RANGE 3 WEST, W.M

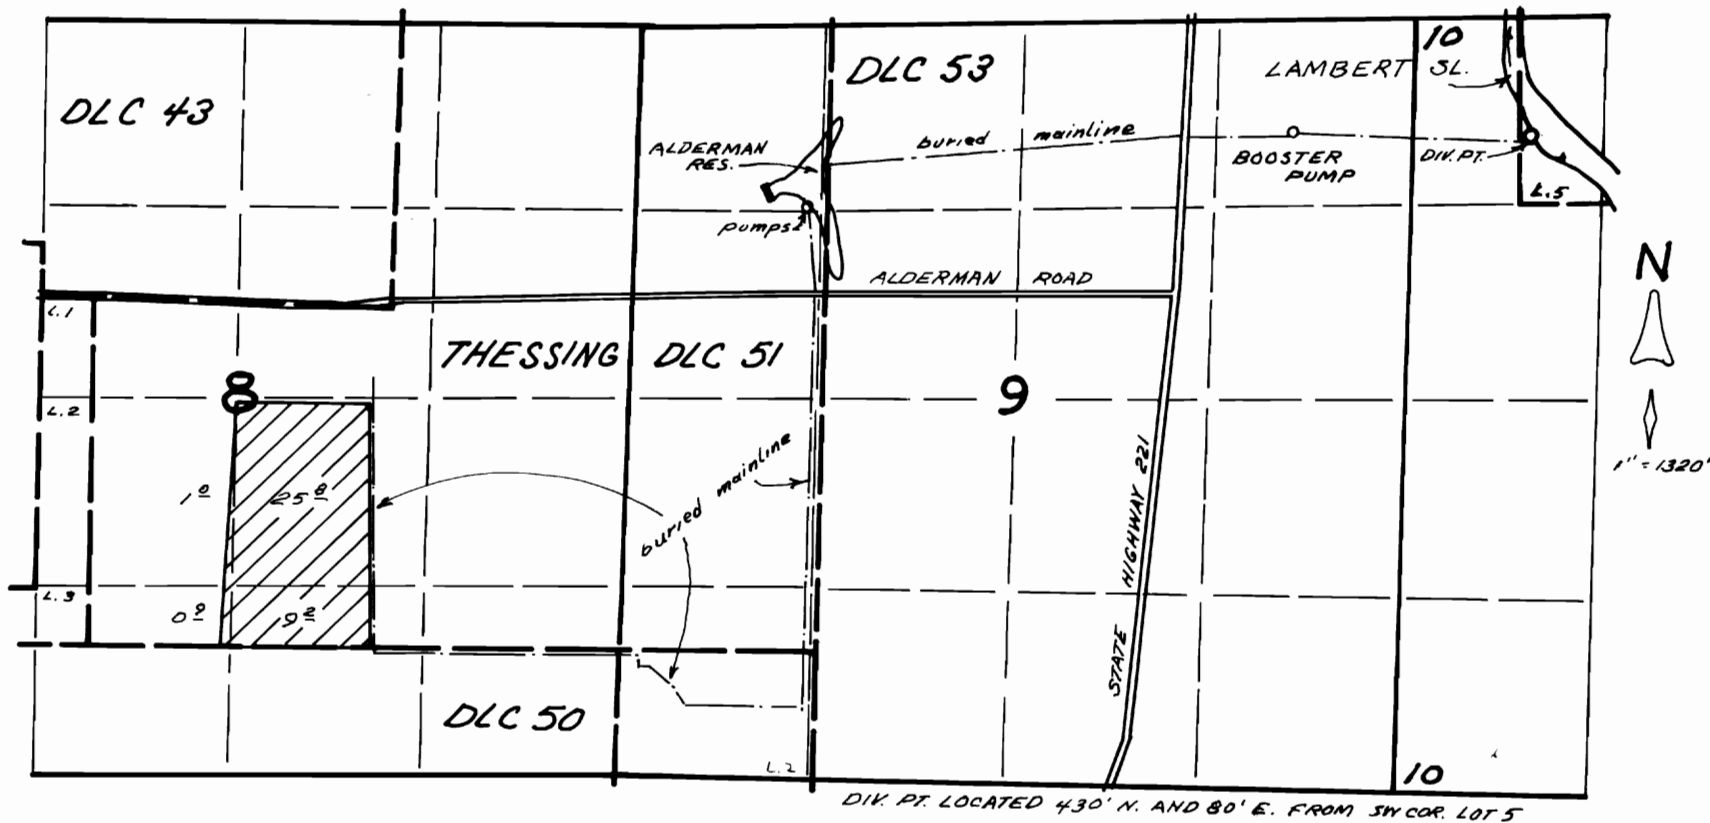

DIK. PT. LOCATED 430' N. AND 80' E. FROM SW COR. LOT 5

WATER RESOURCES DEPT.
SALEM, OREGON

RECEIVED
JUL 20 1999

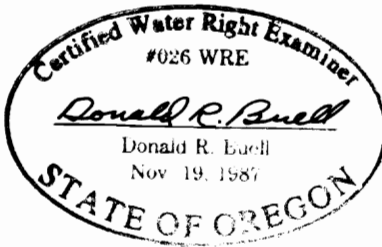

FINAL PROOF SURVEY
UNDER
TRANSFER 7190
IN NAME OF
GORDON BAILEY REVOCABLE LIVING TRUST
JUNE 18, 1999

THIS MAP WAS PREPARED FOR THE PURPOSE OF IDENTIFYING THE LOCATION OF A WATER RIGHT ONLY AND IS NOT INTENDED TO PROVIDE LEGAL DIMENSIONS OR LOCATION OF PROPERTY OWNERSHIP LINES.