


CLAIM OF BENEFICIAL USE SURVEY FOR T-8031

T.34S.,R.2W.,Sec.19 W.M.

Jackson County

November 28, 2000

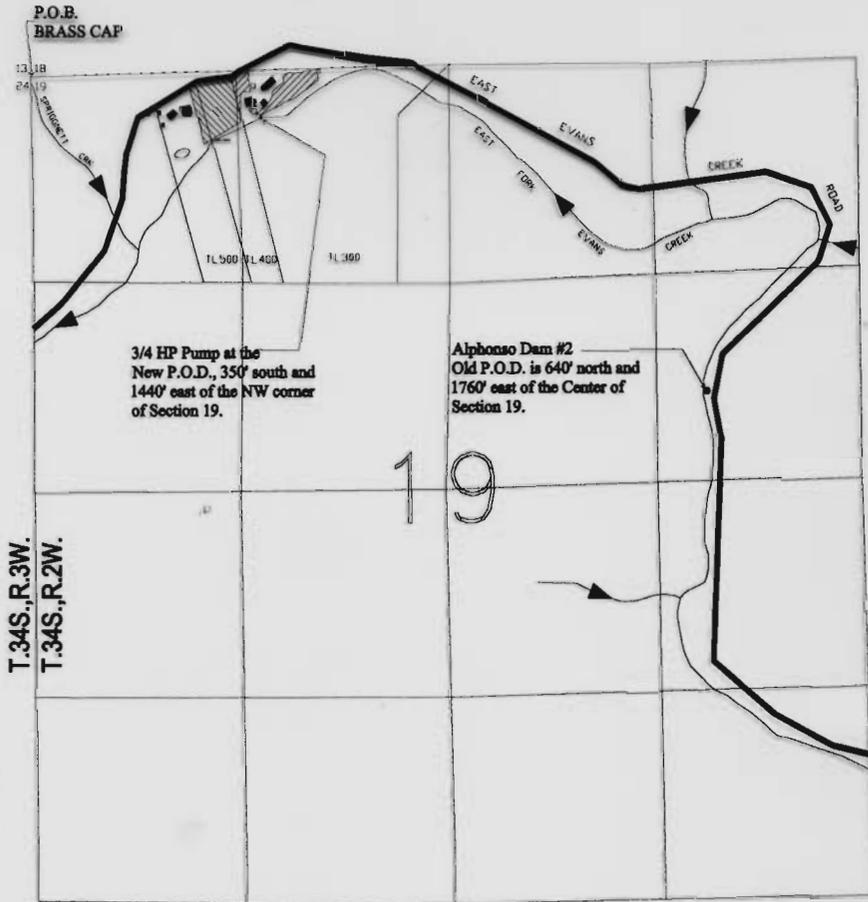

11-28-2000
EXP 12-31-2000



Perfected T-8031 rights with a 1892 priority from East Fork Evans Creek.
0.1 acres in the NW1/4NW1/4, and 1.4 acres in the NE1/4NW1/4 of Section 19.



T-7940 rights with a 1892 priority from East Fork Evans Creek.
0.1 acres in the NE1/4NW1/4, and 1.9 acres in the NW1/4NW1/4 of Section 19.

RECEIVED

DEC 18 2000

WATER RESOURCES DEPT.
SALEM, OREGON

This map was prepared by Gordon R Lyford for Katherine Sheinill and Patricia A. Brown who own tax lot 300. They were granted Transfer Order 8031 on February 10, 1999.

This map was prepared for the purposes of identifying the location of water rights only and is not intended to provide legal dimensions or the location of property ownership lines.