


RECEIVED

JUN - 8 1998

WATER RESOURCES DEPT.  
SALEM, OREGON

# T 19 S, R 34 E, WM

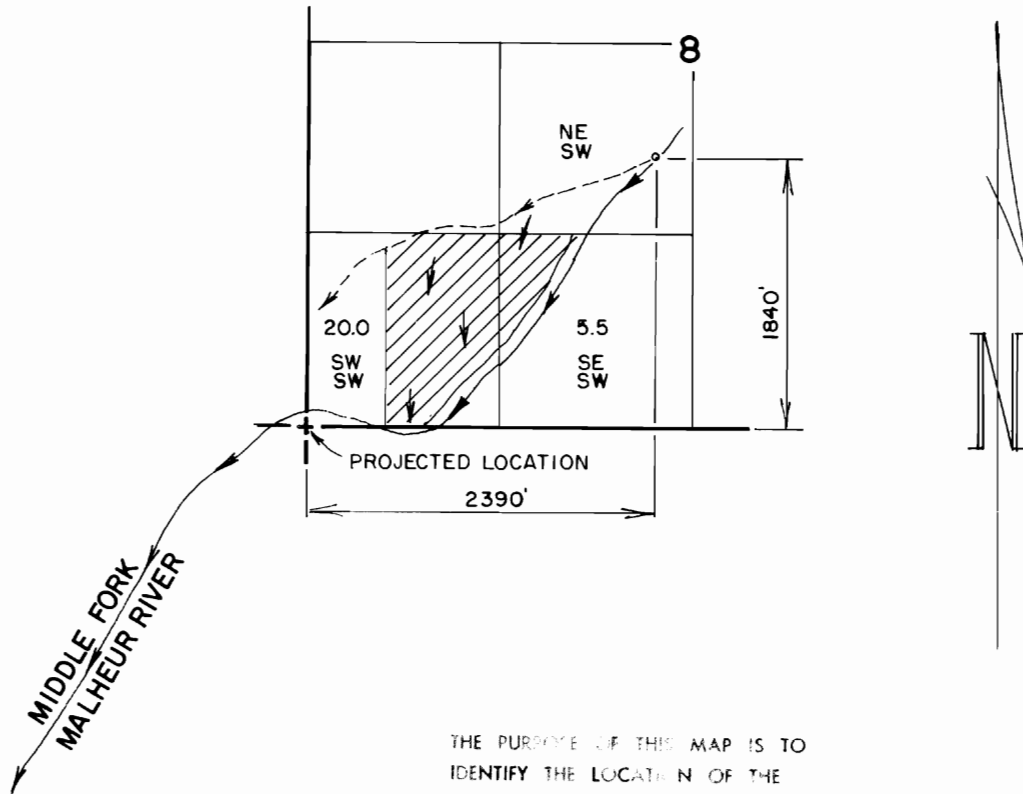

THE PURPOSE OF THIS MAP IS TO IDENTIFY THE LOCATION OF THE WATER RIGHT. IT IS NOT INTENDED TO PROVIDE INFORMATION RELATIVE TO THE LOCATION OF PROPERTY OWNERSHIP.

## FINAL PROOF SURVEY

UNDER  
T-7214

IN THE NAME OF  
JOHN AHMANN

Scale: 4" = 1 MILE

Date: MAY 1998

Job: 1497

Den:

Drn: CHRIS

Ckd:



M. A. PALMER & SONS, INC.  
ENGINEERING & SURVEYING  
254 N. Alder - Box 61  
Burns, Oregon 97720

Sht. No.

of 1

RENEW 1-1-1999