


T.12S.R.6W.W.M.

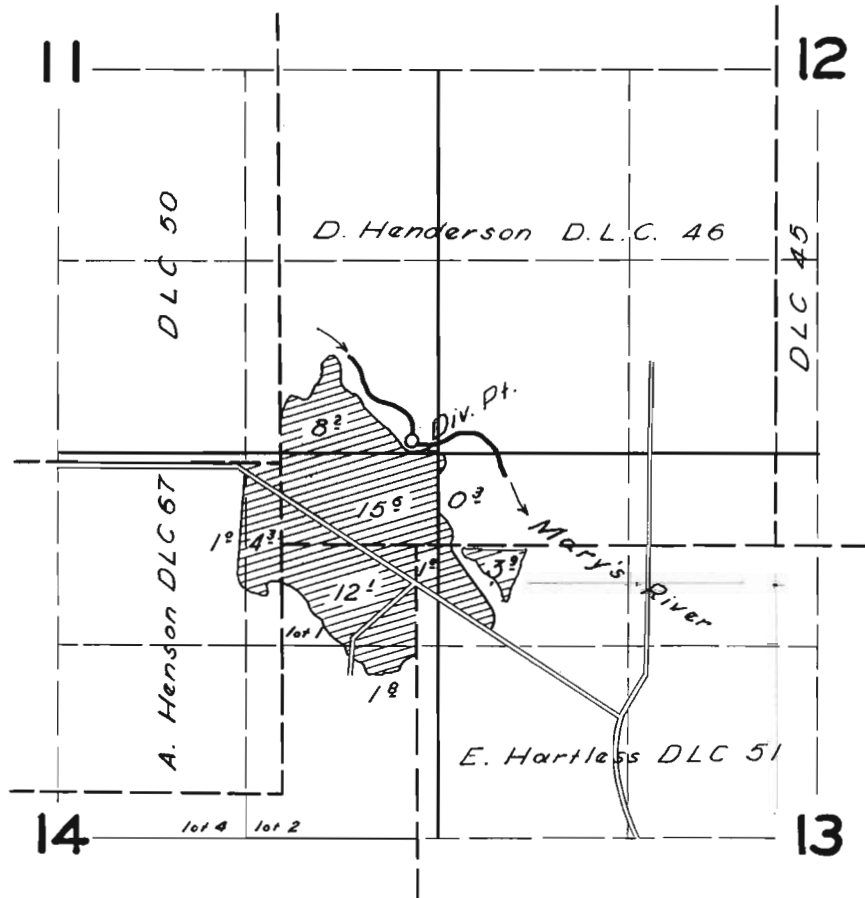

FINAL PROOF SURVEY
UNDER

Application No. 20627 Permit No. 16137
IN NAME OF

Dorval & Arma Bevans

Surveyed 20 Aug 1957, by [Signature]