


# T.6S.R.2W. W.M.

FILED  
 1998  
 COUNTY DEPT

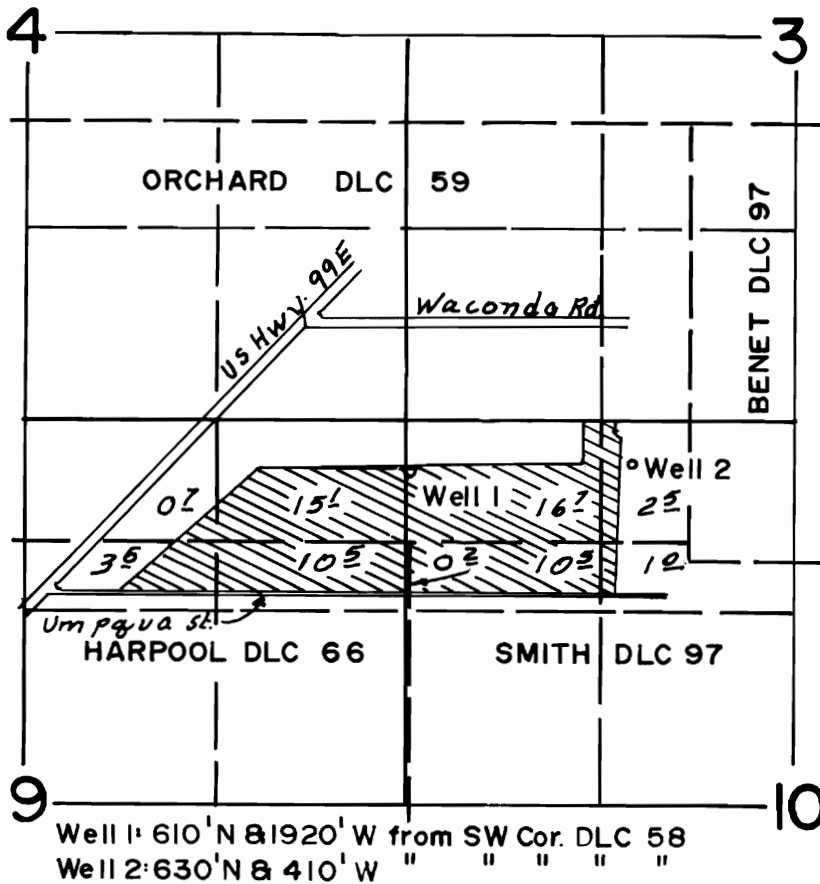


## FINAL PROOF SURVEY UNDER

TRANSFER T-7227  
 Application No. .... Permit No. ....  
 IN NAME OF

..D.&E.LAND..COMPANY.....

Surveyed JULY.8 1998, by .....

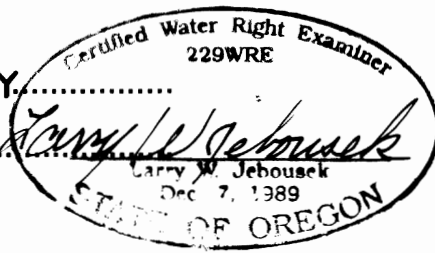

THIS MAP WAS PREPARED FOR THE PURPOSE OF IDENTIFYING THE LOCATION OF A WATER RIGHT ONLY AND IS NOT INTENDED TO PROVIDE LEGAL DIMENSIONS OR LOCATION OF PROPERTY OWNERSHIP LINES.